

PANOLA

N 30

7-10-73

MISSISSIPPI
 BOARD OF WATER COMMISSIONERS
 416 North State Street
 Jackson, Mississippi 39201

CODED

WATER WELL DRILLERS LOG

7-10-1973 date well completed

Bob Smith firm name

Panola county well located

LANDOWNER:

Herbert Cullen

Sardin - Min

(mailing address)

description of formations encountered

Clay Joint

red sand

white clay

white sand

from

to

40

8

8

18

18

75

75

95

WELL LOCATION:

sec. 24 T 8 N R 6 E
 15 miles East of Batesville
 (distance) (direction) (nearest town)

WELL PURPOSE:

Home (home, irrigation, municipal, industrial)

CODED


WELL COMPLETION DATA:

- (1) diameter (inches) 4
- (2) total depth (feet) 95
- (3) static water level (feet) 60 below top of ground.
- (4) casing Plastic, 95 (material), (depth)
- (size) If telescope see back.
- (5) screen 20, 75 (length), (depth to top)
- 4, Plastic (size), (material)
- (6) pump 1/2 (HP), 10 (yield gpm)
- Elec (type power)
- (7) electric log No (yes or no)

(organization running log)

(8) how well bottom plugged


DRILLERS REMARKS:

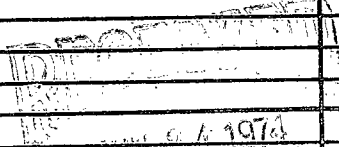

MISS. Bd. OF WATER COMMISSIONERS

If well telescopes please sketch and show depths.

GROUND LEVEL

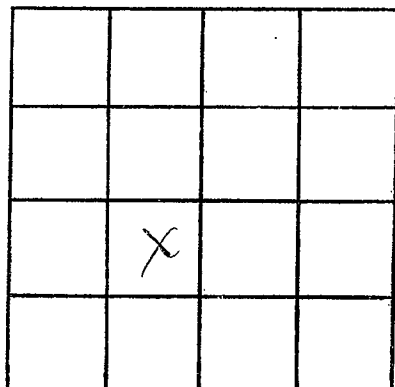

SECTION 24

Please indicate well location X.

ADDITIONAL INFORMATION

If more than one screen, show locations of each on sketch.