

PANOLA
N 31
5-21-73

MISSISSIPPI
BOARD OF WATER COMMISSIONERS
416 North State Street
Jackson, Mississippi 39201

CODED

WATER WELL DRILLERS LOG

5-27-1973
date well completed

Bob Smith
firm name

Panola
county well located

LANDOWNER:

Steve R. Lyle

Sardinia, Miss.
(mailing address)

WELL LOCATION:

sec. 24 T. 8 N R. 6 E
15 miles E of Batesville
(distance) (direction) (nearest town)

WELL PURPOSE: None
(home, irrigation, municipal, industrial)

WELL COMPLETION DATA:

- (1) diameter (inches) 4
- (2) total depth (feet) 122
- (3) static water level (feet) 108 below above top of ground.
- (4) casing Plastic 122
(material) (depth)
- (size) If telescope see back.
- (5) screen 20 102
(length) (depth to top)
- 4 Plastic
(size) (material)
- (6) pump 1/2 10
(HP) (yield gpm)
- B Lee
(type power)
- (7) electric log 20
(yes or no)

(organization running log)

(8) how well bottom plugged
Plugged

DRILLERS REMARKS:

description of formations encountered

from

to

Clay Soil

10 12

Red sand

12 50


gravel

50 80

white sand

80 128

CODED

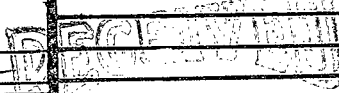

JUN 2 6 1974

If well telescopes please sketch and show depths.

GROUND LEVEL

		X	

SECTION 24

Please indicate well location X.

ADDITIONAL INFORMATION

If more than one screen,
show locations of each on sketch.