

PANOLA
N 35
5-1-74

MISSISSIPPI
BOARD OF WATER COMMISSIONERS
416 North State Street
Jackson, Mississippi 39201

CODED

WATER WELL DRILLERS LOG

5-1-74 19 Bob Smith + Son Panola
date well completed firm name county well located

LANDOWNER:	description of formations encountered	from	to
Mourne Davis			
Memphis, Tenn. well: Sardis, Miss. (mailing address)	Sand	20'	225'
WELL LOCATION: sec. 19 T 8 N R 6 E 20 miles SE of Batesville (distance) (direction) (nearest town)	solid rock	225'	225.8'
WELL PURPOSE: home (home, irrigation, municipal, industrial)	Blue clay	225.8'	-2-
WELL COMPLETION DATA: (1) diameter (inches) 4" (2) total depth (feet) 225' (3) static water level (feet) 89' below top of ground. (4) casing Plastic, 225' (material) (depth) (size) If telescope see back. (5) screen 10' 215' (length) (depth to top) 4" Plastic (size) (material) (6) pump 1/2 10 (HP) (yield gpm) electric (type power) (7) electric log no (yes or no) (organization running log) (8) how well bottom plugged plugged			
DRILLERS REMARKS:			

CODED


RECEIVED

AUG - 5 1974

MISS. RD. OF WATER COMMISSIONERS

If well telescopes please sketch and show depths.

GROUND LEVEL

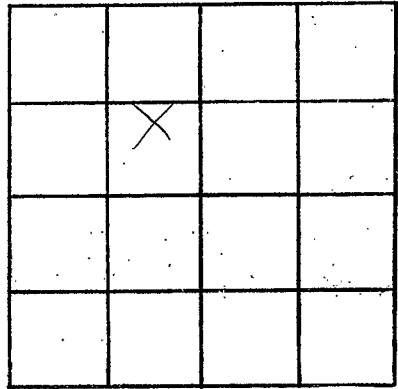

SECTION 19

Please indicate well location X.

ADDITIONAL INFORMATION

If more than one screen, show locations of each on sketch.