

PANOLA
N 37
8-1-74

MISSISSIPPI
BOARD OF WATER COMMISSIONERS
416 North State Street
Jackson, Mississippi 39201

CODED

WATER WELL DRILLERS LOG

8-1-1974 date well completed
Lipe well Co firm name
PANOLA county well located

LANDOWNER:

SAM Hentz
Batesville Miss,
(mailing address)

WELL LOCATION:

sec. 9 T. 8 N R. 6 E
5 miles East of Batesville
(distance) (direction) (nearest town)

WELL PURPOSE:

(home, irrigation, municipal, industrial)

WELL COMPLETION DATA:

- (1) diameter (inches) 4
- (2) total depth (feet) 174
- (3) static water level (feet) 100 below above top of ground.
- (4) casing PVC 164,
(material) (depth)
4 if telescope see back.
(size)
- (5) screen 10 164
(length) (depth to top)
4 PVC
(size) (material)
- (6) pump 3/4 18
(HP) (yield gpm)
elec
(type power)
- (7) electric log NO
(yes or no)
NO
(organization running log)
- (8) how well bottom plugged PVC
plug

description of formations encountered

	from	to
TOP SOIL	0	20
red sand	20	40
cc	40	60
cc	60	80
white sand	80	100
CLAY	100	120
CLAY and sand	120	140
cc	140	160
SAND	160	174

CODED


DRILLERS REMARKS:

RECEIVED
AUG - 7 1974

BD. OF WATER COMMISSIONERS

If well telescopes please sketch and show depths.

GROUND LEVEL

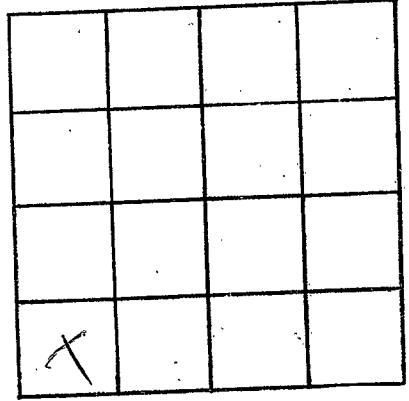

SECTION 9

Please indicate well location X.

ADDITIONAL INFORMATION

If more than one screen,
show locations of each on sketch.