

PANOLA
N38
8-5-74

MISSISSIPPI
BOARD OF WATER COMMISSIONERS
416 North State Street
Jackson, Mississippi 39201

CODED

WATER WELL DRILLERS LOG

8-5-74
date well completed

1974 Bob Smith & Son
firm name

Panola
county well located

LANDOWNER: Bill Mc Arthur
Gulf Trail Lodge
Sardis, Miss.
(mailing address)

description of formations encountered	from	to
top soil	0'	10'
clay and sand	40'	80'
Red sand	10'	80'
clay and sand	80'	100'
sand	100'	115'

WELL LOCATION:
sec. 3 T. 8 N R. 6 E
⑤ (S) (W)
12 miles East of Sardis
(distance) (direction) (nearest town)

WELL PURPOSE: Home
(home, irrigation, municipal, industrial)

- WELL COMPLETION DATA:
- (1) diameter (inches) 4"
 - (2) total depth (feet) 115'
 - (3) static water level (feet) 85' below top of ground.
 - (4) casing Plastic, 115'
(material) (depth)
(size) if telescope see back.
 - (5) screen 10', 105'
(length) (depth to top)
4", Plastic
(size) (material)
 - (6) pump 1/3, 5
(HP) (yield gpm)
electric
(type power)
 - (7) electric log no
(yes or no)
- (organization running log)

(8) how well bottom plugged plugged

DRILLERS REMARKS:


CODED

RECEIVED
RECEIVED

AUG 10 1974

If well telescopes please sketch and show depths.

GROUND LEVEL

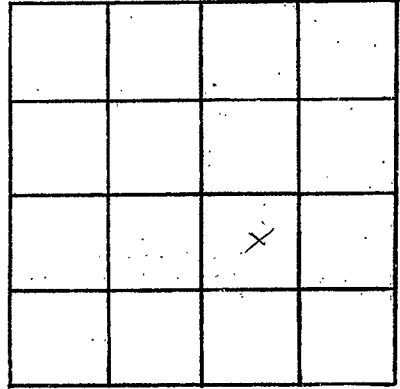

SECTION 3

Please indicate well location X.

ADDITIONAL INFORMATION

If more than one screen, show locations of each on sketch.