

PANOLA
N 39
8-5-74

MISSISSIPPI
BOARD OF WATER COMMISSIONERS
416 North State Street
Jackson, Mississippi 39201

CODED

WATER WELL DRILLERS LOG

8-5-1974 date well completed W. A. Mason firm name Panola county well located

LANDOWNER:
Mt. Zion Church
Sardis Miss.
(mailing address)

description of formations encountered	from	to
Clay with	70	10
Rock	10	14
Red sand	14	50
Rock	50	51
White sand	51	60
Blue clay	60	140
White sand gray	140	186

WELL LOCATION:
sec 29 T 8 N R 6 E
5 1/2 miles SE of Sardis
(distance) (direction) (nearest town)

WELL PURPOSE:
(home, irrigation, municipal, industrial)

WELL COMPLETION DATA:

(1) diameter (inches) 4"

(2) total depth (feet) 186'

(3) static water level (feet) 54' below top of ground.

(4) casing Plastic 176'
(material) (depth)
4" if telescope see back.
(size)

(5) screen 10' 176'
(length) (depth to top)
4" Plastic
(size) (material)

(6) pump 1/2 7
(HP) (yield gpm)
electric
(type power)

(7) electric log No
(yes or no)

(organization running log)

(8) how well bottom plugged Cap

CODED


RECEIVED
DEC 27 1974

MISS. RD. OF WATER COMM

DRILLERS REMARKS:

If well telescopes please sketch and show depths.

GROUND LEVEL

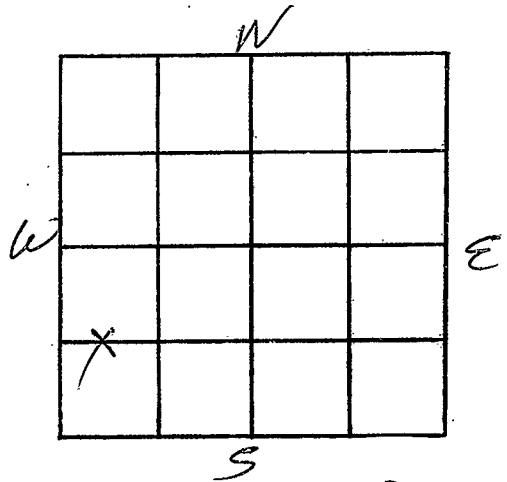

SECTION 29

Please indicate well location X.

ADDITIONAL INFORMATION

If more than one screen, show locations of each on sketch.