

PANOLA  
N 40  
8-5-74

MISSISSIPPI  
BOARD OF WATER COMMISSIONERS  
416 North State Street  
Jackson, Mississippi 39201

CODED

WATER WELL DRILLERS LOG

8-5-1974  
date well completed

W.R. Mason  
firm name

Panola  
county well located

LANDOWNER:	description of formations encountered	from	to
Clara Pique Rt. Sardinis Mills. (mailing address)			
	blue clay	6	52
	coarse sand	52	80
	black clay	at	80
WELL LOCATION:			
sec. 32 T. 8 N. R. 6 E. 1 miles South of Vesta (distance) (direction) (nearest town)			
WELL PURPOSE: Home (home, irrigation, municipal, industrial)			
WELL COMPLETION DATA:			
(1) diameter (inches) 4"			
(2) total depth (feet) 80'			
(3) static water level (feet) 35' below top of ground.			
(4) casing Plastic 70' (material) (depth) 4" (size) If telescope see back.			
(5) screen 10' 70' (length) (depth to top) 4" Plastic (size) (material)			
(6) pump 1/3 5 (HP) (yield gpm) electric (type power)			
(7) electric log No (yes or no)			
(organization running log)			
(8) how well bottom plugged cap			
DRILLERS REMARKS:			

CODED


RECEIVED  
DEC 27 1974

DEC 27 1974

MISS. RD. OF WATER COMM.

If well telescopes please sketch and show depths.

GROUND LEVEL

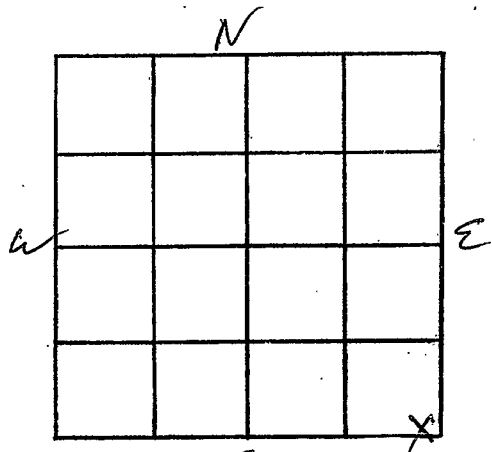

SECTION 32

Please indicate well location X.

ADDITIONAL INFORMATION

If more than one screen, show locations of each on sketch.