

PANOLA
N41
1-6-75

MISSISSIPPI
BOARD OF WATER COMMISSIONERS
416 North State Street
Jackson, Mississippi 39201

CODED

WATER WELL DRILLERS LOG

1-6 date well completed 1975 LIPE Well Co. firm name Panola county well located

LANDOWNER: M. F. Hilburn
Batesville Miss. (mailing address)

description of formations encountered	from	to
TOP Soil	0	20
Clay and sand	20	40
Clay	40	60
SAND	60	80
LL	80	104

WELL LOCATION:
sec 14 T 8 N R 6 E
7 miles east of Batesville
(distance) (direction) (nearest town)

WELL PURPOSE:
(home, irrigation, municipal, industrial)

WELL COMPLETION DATA:
(1) diameter (inches) 2"
(2) total depth (feet) 104
(3) static water level (feet) 0 below above top of ground.
(4) casing PVC 80 (material) (depth) 2" if telescope see back. (size)
(5) screen 24' 80 (length) (depth to top) 2 PVC (size) (material)
(6) pump flowing 30 (HP) (yield gpm)
(type power)
(7) electric log (yes or no)
(organization running log)
(8) how well bottom plugged

CODED


REGISTERED
FEB 5 - 1975

DRILLERS REMARKS:
flowing well

MISS. BD. OF WATER COMM

If well telescopes please sketch and show depths.

GROUND LEVEL

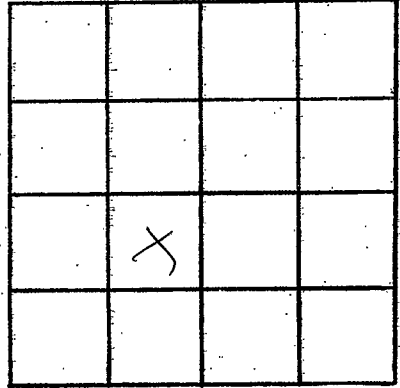

SECTION 144

Please indicate well location X.

ADDITIONAL INFORMATION

If more than one screen,
show locations of each on sketch.