

PANOLA
N 42
S-2-75

MISSISSIPPI
BOARD OF WATER COMMISSIONERS
416 North State Street
Jackson, Mississippi 39201

BIG STEAM
WATER WELL DRILLERS LOG

5-2-1975
date well completed

JBC
firm name

138 Panola CODED
county well located

LANDOWNER Billy Bramlett
Batesville MS
(mailing address)

description of formations encountered	from to	
Sandy Clay	0	90
Blue Clay	90	130
Sand	130	154

WELL LOCATION:
sec 34 T 8 N R 6 E
S₁ W
6 miles N-E of Batesville
(distance) (direction) (nearest town)

WELL PURPOSE: Home
(home, irrigation, municipal, industrial)

- WELL COMPLETION DATA:
- (1) diameter (inches) 4"
 - (2) total depth (feet) 154'
 - (3) static water level (feet) 125 below top of ground
 - (4) casing Plastic 154'
(material) (depth)
 - (size) If telescope see back.
 - (5) screen 10' 144'
(length) (depth to top)
 - 4" Plastic
(size) (material)
 - (6) pump 1/2 8
(HP) (yield gpm)
 - Elect
(type power)
 - (7) electric log NO
(yes or no)

(organization running log)
(8) how well bottom plugged Plug


DRILLERS REMARKS:

RECEIVED
MAY 18 1975

MISS. BD. OF W. COM.

If well telescopes please sketch and show depths.

GROUND LEVEL

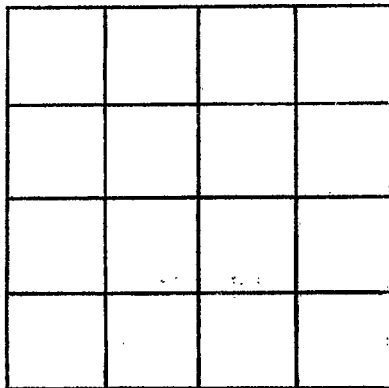

SECTION _____

Please indicate well location X.

ADDITIONAL INFORMATION

If more than one screen, show locations of each on sketch.