

N 43
 Penola
 5/20/75

MISSISSIPPI
 BOARD OF WATER COMMISSIONERS
 416 North State Street
 Jackson, Mississippi 39201

CODED

WATER WELL DRILLERS LOG

5-20 1975 J. B. Orr Penola
 date well completed firm name county well located


LANDOWNER	description of formations encountered	from	to
Mrs. Bailey Batesville, ms Blackjack (mailing address)	Sand	0	240
WELL LOCATION: sec. 36 T. 8 N. R. 6 E. 8 miles N-E of Batesville (distance) (direction) (nearest town)			
WELL PURPOSE: Home (home, irrigation, municipal, industrial)			
WELL COMPLETION DATA:			
(1) diameter (inches) 4"			
(2) total depth (feet) 240			
(3) static water level (feet) 80 below top of ground			
(4) casing Plastic, 240, (material) (depth)			
If telescope see back. (size)			
(5) screen 10', 230 (length) (depth to top)			
4" Plastic (size) (material)			
(6) pump 3/4, 12 (HP) (yield gpm)			
Elect (type power)			
(7) electric log No (yes or no)			
(organization running log)			
(8) how well bottom plugged 2" Ballon			
DRILLERS REMARKS:			
JUN 9 1975			
MISSISSIPPI BOARD OF WATER COMMISSIONERS			

CODED

MISSISSIPPI BOARD OF WATER COMMISSIONERS

If well telescopes please sketch and show depths.

GROUND LEVEL

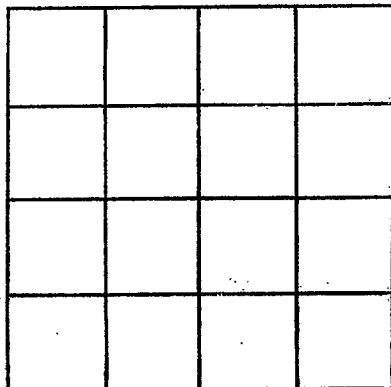

SECTION _____

Please indicate well location X.

ADDITIONAL INFORMATION

If more than one screen,
show locations of each on sketch.