

panola
144
8-5-75

MISSISSIPPI
 BOARD OF WATER COMMISSIONERS
 416 North State Street
 Jackson, Mississippi 39201

CODED

WATER WELL DRILLERS LOG

8-5 1975 Lipe well Co. Panola
 date well completed firm name county well located

LANDOWNER: Willie Stitt
Sardis Miss.
 (mailing address)

description of formations encountered	from	to
<u>Top soil</u>	<u>0</u>	<u>20</u>
<u>Gravel and sand</u>	<u>20</u>	<u>40</u>
<u>Sand</u>	<u>40</u>	<u>64</u>

WELL LOCATION:
 sec. 6 T. 2 N. R. 6 E. 15F
3 miles south of Sardis
 (distance) (direction) (nearest town)

WELL PURPOSE:
 (home) irrigation, municipal, industrial

- WELL COMPLETION DATA:
- (1) diameter (inches) 4
 - (2) total depth (feet) 64'
 - (3) static water level (feet) 25' below above top of ground.
 - (4) casing PVC 54'
 (material) (depth)
4 if telescope see back.
 (size)
 - (5) screen 10 54
 (length) (depth to top)
4 PVC
 (size) (material)
 - (6) pump 3/4 10
 (HP) (yield gpm)
elec.
 (type power)
 - (7) electric log no
 (yes or no)
no
 (organization running log)
 - (8) how well bottom plugged PVC
cap


CODED

RECEIVED
 SEP 24 1975

DRILLERS REMARKS:

If well telescopes please sketch and show depths.

GROUND LEVEL

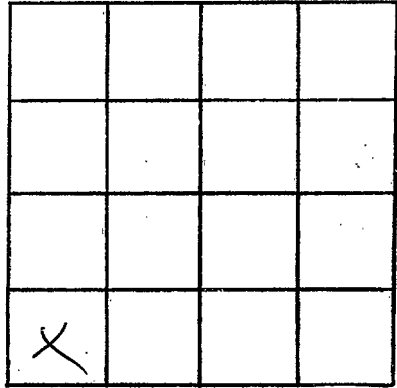

SECTION 6

Please indicate well location X.

ADDITIONAL INFORMATION

If more than one screen,
show locations of each on sketch.