
	State Well Re	eport	For Office Use Only:
County: PANGIA-	Part 1		For Onice Use Only:
Permit #:	Mississippi Department of Environmental Quality		er:
	Office of Land and Wate P.O. Box 1063	Well #	N-54
Driller: <u>RLiphqfone</u>	Jackson, MS 39289	D-0631 L. S. H	Elevation:
Date drilling completed: <u>6 - 21 - 05</u>	(601)961-521		
	(601)354-6938 (	E-log	#:
State Law requires that this repo	ort be prepared by the driller i	n detail and filed with the	Department within
30 days of completion of drilling	of the well.		
Well Owner Informa		Well Locati	
Owner Name IX& BuckinghAM		e:' Lon	gitude:''
Mailing Address: King R	Method	of Lat/Long (circle one): Co	nventional Survey,
- · · · ·		USGS quad, Hand-held GPS, Survey-grade GPS	
No 911 yer		-	
<u>SH-Ad'S</u> City Sta	<u>15</u>	4 <u>14 Sec 5</u> Twi	n <u> </u>
City Sta	Distanc	e Direction No	earest Town
Telephone No. ()		Miles <u>4</u> of <u>5</u>	and's Lake
	Well Data		
$\frown$			
Purpose of Well (circle one) Home Ind			
Date well drilling started:6-16-0	5 Date well drill	ng completed: <u>6 - 16 -</u>	05 (Drining ca
If flowing, method of flow regulation: Val	ve Other (describe)		
-			
Static Water Level: <u>60</u> feet al	ove or below (circle one) land surfa	ce Date measured: <u>(e</u>	- 10-03
Method of Measurement (circle one) ş		line other: <u>57-e e/ n</u>	
	eel tape electric tape air	line other: <u>57-e e/ n</u>	MM on 871 mg
Hole depth: Well de	eel tape electric tape air pth: Well	line other: <u>57-e e/ n</u>	MM on 871 ing
Hole depth: <b>120</b> Well de Type of grout (circle one): Cement	eel tape electric tape air pth: <u>120</u> Well Rentonite Mix	line other: <u>57-e c/ n</u> grouted to a depth of <u>/C</u>	1411 ON 871- Ing
Hole depth: <b>120</b> Well de Type of grout (circle one): Cement	eel tape electric tape air pth: <u>120</u> Well Rentonite Mix	line other: <u>57-e c/ n</u> grouted to a depth of <u>/C</u>	1411 ON 871- In 9 feet
Hole depth: <b>120</b> Well de Type of grout (circle one): Cement	eel tape electric tape air pth: <u>120</u> Well Rentonite Mix	line other: <u>57-e c/ n</u> grouted to a depth of <u>/C</u>	1411 ON 871- In 9 feet
Hole depth: <u>120</u> Well de Type of grout (circle one): Cement Casing length: <u>20</u> feet Casi Screen length: <u>10</u> feet Scree	eel tape electric tape air pth: <u>120</u> Well Rentonite Mix ng diameter: <u>4</u> inches	line other: <u>57~2/ M</u> grouted to a depth of <u>//</u> Type of casing: <u>M//</u> Type of screen: <u>5497</u>	feet feet
Hole depth: Well de Type of grout (circle one): Cement Casing length: feet Casi Screen length: feet Screen Screen slot size: e / 3 inches	eel tape electric tape air pth: <u>120</u> Well <u>Bentonite</u> Mix ng diameter: <u>4</u> inches sen diameter: <u>4</u> inches Setting depth: From <u>110</u>	line other: <u>57~c/</u> M grouted to a depth of <u>//</u> Type of casing: <u>////</u> Type of screen: <u>5 to 7</u> feet to <u>//20</u>	feet feet
Hole depth: <u>120</u> Well de Type of grout (circle one): Cement Casing length: <u>20</u> feet Casi Screen length: <u>10</u> feet Scree	eel tape electric tape air pth: <u>120</u> Well <u>Bentonite</u> Mix ng diameter: <u>4</u> inches sen diameter: <u>4</u> inches Setting depth: From <u>110</u>	line other: <u>57~c/</u> M grouted to a depth of <u>//</u> Type of casing: <u>////</u> Type of screen: <u>5 to 7</u> feet to <u>//20</u>	feet feet
Hole depth: Well de Type of grout (circle one): Cement Casing length: feet Casi Screen length: feet Scree Screen slot size: 2 / 3 inches	eel tape  electric tape  air    pth:  120  Well    Hentonite  Mix    ng diameter:  4  inches    sen diameter:  4  inches    Setting depth:  From  110    Gravel packed  Underreamed	line other: <u>57~c(</u> ) grouted to a depth of <u>12</u> Type of casing: <u>12</u> Type of screen: <u>5407</u> feet to <u>120</u> Telescoped Open hole	feet feet feet feet Natural Development
Hole depth: Well de Type of grout (circle one): Cement Casing length: feet Casi Screen length: feet Screen Screen slot size: e / 3_ inches Type of completion (circle all applicable):	eel tape  electric tape  air    pth:	line other: <u>57~c/</u> M grouted to a depth of <u>//</u> Type of casing: <u>M//</u> Type of screen: <u>5407</u> <u>feet to _/20</u> Telescoped Open hole	feet feet feet <u>feet</u> <u>feet</u> <u>Natural Development</u>
Hole depth: Well de Type of grout (circle one): Cement Casing length: feet Casi Screen length: feet Screen Screen slot size: feet Screen Screen slot size: feet Screen Type of completion (circle all applicable): Top of lap pipe or reduction in casing:	eel tape  electric tape  air    pth:  120  Well    Hentonite  Mix    ng diameter:  4  inches    sen diameter:  4  inches    Setting depth:  From  110    Gravel packed  Underreamed  Other (describe):  110    Montfeet.  If telescoped  110	line other: <u>57~c(</u> ) grouted to a depth of <u>12</u> Type of casing: <u>12</u> Type of screen: <u>5407</u> <u>feet to 120</u> Telescoped Open hole or more than one screen, de	feet feet feet <u>feet</u> <u>feet</u> <u>natural Development</u> scribe on back of page
Hole depth: Well de Type of grout (circle one): Cement Casing length: feet Casi Screen length: feet Screen Screen slot size: e / 3_ inches Type of completion (circle all applicable):	eel tape  electric tape  air    pth:  120  Well    Hentonite  Mix    ng diameter:  4  inches    sen diameter:  4  inches    Setting depth:  From  110    Gravel packed  Underreamed  Other (describe):  110    Montfeet.  If telescoped  110	line other: <u>57~c(</u> ) grouted to a depth of <u>12</u> Type of casing: <u>12</u> Type of screen: <u>5407</u> <u>feet to 120</u> Telescoped Open hole or more than one screen, de	feet feet feet <u>feet</u> <u>feet</u> <u>scribe on back of page</u>
Hole depth: Well de Type of grout (circle one): Cement Casing length: feet Casi Screen length: feet Screen Screen slot size: feet Screen Screen slot size: feet Screen Type of completion (circle all applicable): Top of lap pipe or reduction in casing: Logs run (circle all applicable): No log run	eel tape electric tape air pth: <u>120</u> Well Fentonite Mix ng diameter: <u>4</u> inches sen diameter: <u>4</u> inches Setting depth: From <u>110</u> Gravel packed Underreamed Other (describe): <u></u> <u>MOMM_feet. If telescoped</u> n Electric Gamma Ray Densit	line other: <u>Sree(</u> M grouted to a depth of <u>12</u> Type of casing: <u>12</u> Type of screen: <u>Ster</u> feet to <u>120</u> Telescoped Open hole <b>or more than one screen, de</b> y Sonic Neutron Other:	feet feet feet feet Natural Development scribe on back of page
Hole depth: Well de Type of grout (circle one): Cement Casing length: feet Casi Screen length: feet Screen Screen slot size: feet Screen Screen slot size: feet Screen Type of completion (circle all applicable): Top of lap pipe or reduction in casing: Logs run (circle all applicable): No log run	eel tape electric tape air pth: <u>120</u> Well Fentonite Mix ng diameter: <u>4</u> inches sen diameter: <u>4</u> inches Setting depth: From <u>110</u> Gravel packed Underreamed Other (describe): <u></u> <u>MOMM_feet. If telescoped</u> n Electric Gamma Ray Densit	line other: <u>Sree(</u> M grouted to a depth of <u>12</u> Type of casing: <u>12</u> Type of screen: <u>Ster</u> feet to <u>120</u> Telescoped Open hole <b>or more than one screen, de</b> y Sonic Neutron Other:	feet feet feet feet Natural Development scribe on back of page
Hole depth: Well de Type of grout (circle one): Cement Casing length: feet Casi Screen length: feet Scree Screen slot size: feet Scree Screen slot size: e 1 3 inches Type of completion (circle all applicable): Top of lap pipe or reduction in casing: Logs run (circle all applicable): <u>No log run</u>	eel tape  electric tape  air    pth:  / 1 0  Well    Fentonite  Mix    ng diameter:  //	line other: <u>Sree(</u> M grouted to a depth of <u></u> [C Type of casing: <u>MU</u> Type of screen: <u>Ster</u> feet to <u>12C</u> Telescoped Open hole <b>or more than one screen, de</b> y Sonic Neutron Other: <b>ce with all applicable require</b>	feet feet feet <u>feet</u> <u>feet</u> <u>natural Development</u> scribe on back of page
Hole depth: Well depth: Well depth: Well depth: Well depth: Certement Casing length: feet Casi Screen length: feet Screen Screen slot size: feet Screen Screen slot size: feet Screen Type of completion (circle all applicable): Top of lap pipe or reduction in casing: Logs run (circle all applicable): No log run Name of organization running log(s): I certify that the well was drilled, constru	eel tape  electric tape  air    pth:  / 1 0  Well    Fentonite  Mix    ng diameter:  //	line other: <u>STeel</u> M grouted to a depth of <u>12</u> Type of casing: <u>12</u> Type of screen: <u>5497</u> feet to <u>120</u> Telescoped Open hole or more than one screen, de y Sonic Neutron Other: ce with all applicable require of Health regulations and st	feet feet <u>feet</u> <u>feet</u> <u>feet</u> <u>scribe on back of page</u> ements of the Mississipp ate laws.
Hole depth:  120  Well depth    Type of grout (circle one):  Cement    Casing length:  20  feet  Casing    Screen length:  100  feet  Screen    Screen slot size:  100  feet  Screen    Type of completion (circle all applicable):  Top of lap pipe or reduction in casing:	eel tape  electric tape  air    pth:	line other: <u>Sree(</u> M grouted to a depth of <u></u> [C Type of casing: <u>MU</u> Type of screen: <u>Ster</u> feet to <u>12C</u> Telescoped Open hole <b>or more than one screen, de</b> y Sonic Neutron Other: <b>ce with all applicable require</b>	feet feet feet feet Natural Development scribe on back of page ements of the Mississipp ate laws.
Hole depth:  120  Well depth    Type of grout (circle one):  Cement    Casing length:  20  feet  Casing    Screen length:  100  feet  Screen    Screen slot size:  100  feet  Screen    Type of completion (circle all applicable):  Top of lap pipe or reduction in casing:  1    Logs run (circle all applicable):  No log run  Name of organization running log(s):  1    I certify that the well was drilled, constr  Department of Environmental Quality at the set of the set	eel tape  electric tape  air    pth:  / 1.0  Well    Fentonite  Mix    ng diameter:  //	line other: <u>STeel</u> M grouted to a depth of <u>12</u> Type of casing: <u>12</u> Type of screen: <u>5497</u> feet to <u>120</u> Telescoped Open hole or more than one screen, de y Sonic Neutron Other: ce with all applicable require of Health regulations and st	feet <u>feet</u> <u>feet</u> <u>feet</u> <u>feet</u> <u>natural Development</u> <u>scribe on back of page</u> <u>scribe on back of page</u> <u>feet</u> <u>scribe on back of page</u> <u>feet</u> <u>feet</u> <u>fe</u>
Hole depth: Well de Type of grout (circle one): Cement Casing length: feet Casi Screen length: feet Scree Screen slot size: feet Scree Screen slot size: feet Scree Type of completion (circle all applicable): Top of lap pipe or reduction in casing: Logs run (circle all applicable): No log ru Name of organization running log(s): I certify that the well was drilled, construction of Environmental Quality applicable of the second secon	eel tape  electric tape  air    pth:  / 1.0  Well    Fentonite  Mix    ng diameter:  //	line other: <u>Erec(M</u> grouted to a depth of <u>12</u> Type of casing: <u>127</u> Type of screen: <u>Eter</u> feet to <u>120</u> Telescoped Open hole or more than one screen, de y Sonic Neutron Other: ce with all applicable require of Health regulations and st <u>Eternfr</u> Signature of Water	feet <u>feet</u> <u>feet</u> <u>feet</u> <u>feet</u> <u>natural Development</u> <u>scribe on back of page</u> <u>scribe on back of page</u> <u>feet</u> <u>scribe on back of page</u> <u>feet</u> <u>feet</u> <u>fe</u>
Hole depth:	eel tape  electric tape  air    pth:  / 1.0  Well    Fentonite  Mix    ng diameter:  //	line other: $\overline{ST + c} (M)$ grouted to a depth of	feet feet feet <u>feet</u> <u>feet</u> <u>scribe on back of page</u> <u>scribe on back of page</u>
Hole depth: Well de Type of grout (circle one): Cement Casing length: feet Casi Screen length: feet Scree Screen slot size: feet Scree Screen slot size: e 1 3 inches Type of completion (circle all applicable): Top of lap pipe or reduction in casing: Logs run (circle all applicable): No log ru Name of organization running log(s): I certify that the well was drilled, constr Department of Environmental Quality a 	eel tape  electric tape  air    pth:  / 1.0  Well    Fentonite  Mix    ng diameter:  //	line other: $\[ \] \[ \] \[ \] \] \[ \] \] \] \] \] \] \] \] \] \] \] \] \] $	feet feet feet Natural Development scribe on back of page ements of the Mississipp ate laws. Carry Carl Well Contractor
Hole depth:  120  Well degree    Type of grout (circle one):  Cement    Casing length:  20  feet  Casi    Screen length:  100  feet  Screet    Screen slot size:  100  feet  Screet    Type of completion (circle all applicable):  Top of lap pipe or reduction in casing:  100    Logs run (circle all applicable):  No log run  Name of organization running log(s):  100    I certify that the well was drilled, constr  Department of Environmental Quality at the set of the s	eel tape  electric tape  air    pth:  / 1.0  Well    Fentonite  Mix    ng diameter:  //	line other: <u>Erec(M</u> grouted to a depth of <u>12</u> Type of casing: <u>127</u> Type of screen: <u>Eter</u> feet to <u>120</u> Telescoped Open hole or more than one screen, de y Sonic Neutron Other: ce with all applicable require of Health regulations and st <u>Eternfr</u> Signature of Water	<u>feet</u> <u>feet</u> <u>feet</u> <u>feet</u> <u>natural Development</u> scribe on back of page <u>ements of the Mississipp</u> ate laws.

. If well telescopes please sketch below and show depths.



	Description of Formations Encountered	From	То
	O'R7	0	(1)
-	EAND	10	20
	EANAtciny	20	20
	SANC	90	120
	ERNE + CIRY ERNE ETOPPEL ON HROCH		

If more than one screen, show location of each on sketch

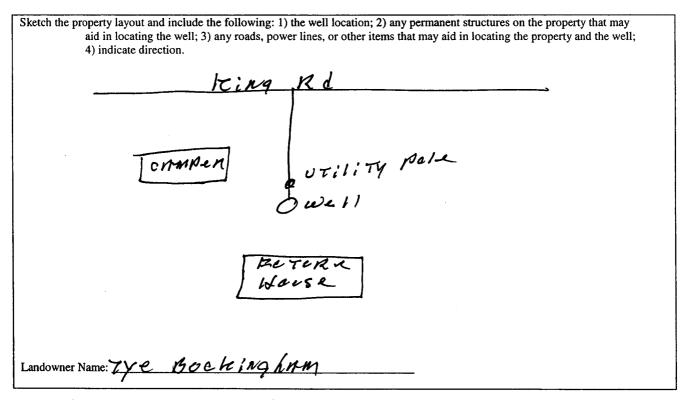

Signature of Water Well Copyractor an

RECEIVED JUL 1 + 2005 BY: OLWH

N-54

	נ ך	ELL REPORT Part 2	For Office Use Only:	
County:P Permit #:	Pump Installer's Completion Report Mississippi Department of Environmental Quality Office of Land and Water Resources P.O. Box 10631 Jackson, MS 39289-0631		Aquifer:	
Permit #: Driller: <u>IZ LANGFON6</u>			Well #: <u>N-54</u>	
Date completed: <u>6-21-05</u>	(60)	1)961-5210 54-6938 (fax)	Elevation:	
This report should be prepared by t			nt within 30 days of the	
installation of pump.			Il Location	
	Well Owner Information			
Owner Name: Tye Bickin		Latitude:	_ Longitude:	
Nailing Address: King Rk		Method of Lat/Long (circle or	ne): Conventional Survey,	
		USGS quad, Hand	d-held GPS, Survey-grade GPS	
		1/4 1/4 Sec	Twn 89 Rng 6 W	
City State	Zip Code	Distance Direction	Nearest Town	
Selephone No. ()		Miles	of SHARDLS LAKE	
Ритр Туре		1	wer Type	
Circle one			Circle one	
hir Lift Jet	Submersible		ne Engine Natural Gas	
Bucket Piston	Turbine	Electric Motor Hand		
Centrifugal Rotary	Flowing Well	Windmill Other	(specify):	
Other (specify):		Horse Power Rating of Motor		
Date Pump Installed: 6-21-	05	Setting Depth: 10-0	feet	
Rated Pump Capacity: / 5 +	Gallons Per Minute	Number of Stages: / 2		
Pump Test Data			easuring Water Level	
Date Well Tested: $6 - 16 - 0$	5			
Static Water Level (A): <u>50</u> Fee	et Below Land Surface			
Pumping Water Level (B): <u>50</u> Fee	t Below Land Surface	Other (specify): <u>5 (20)</u>	Han on STRING	
Drawdown [(B) - (A)]: Fee	et Below Land Surface	For flowing well, measured s	hut in head:feet	
$\int awu u w ii [(D) - (A)] U J I U$			CDM and the share have a f	
Fest Pumping Rate:/G +	Gallons Per Minute	Well yielded 15+	GPM with a drawdown of	

I HEREBY CERTIFY that the above statements are true to the best of my knowledge.

FRANK LANGFORD 0-622 Print Name of Pump Installer and License No. (if applicable)

Frank Langbard Signature of Pump Installer

JUL 14 2005 BY: OLWR