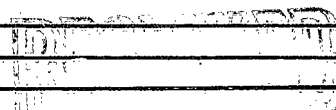


Panola  
 N 2000  
 12-5-75

MISSISSIPPI  
 BOARD OF WATER COMMISSIONERS  
 416 North State Street  
 Jackson, Mississippi 39201

WATER WELL DRILLERS LOG

12-5 1975 Lipe Well Co. Panola  
 date well completed firm name county well located

LANDOWNER:	description of formations encountered	from	to
Tommy Merphey	black sand	0	20
sardi's Miss.	sand	20	40
(mailing address)	clay	40	60
WELL LOCATION:	sand and clay	60	140
sec. 8 T. 8 N R. 6 E	good sand	140	160
7 miles <sup>NE</sup> of Batesville			
(distance) (direction) (nearest town)			
WELL PURPOSE: (home, irrigation, municipal, industrial)			
WELL COMPLETION DATA:			
(1) diameter (inches) 2			
(2) total depth (feet) 160			
(3) static water level (feet) <sup>flowing</sup> below top of ground.			
(4) casing PVC 130' (material) (depth)			
2 (size) if telescope see back.			
(5) screen 30' 130' (length) (depth to top)			
2 PVC (size) (material)			
(6) pump flowing 50 (HP) (yield gpm)			
(type power)			
(7) electric log no (yes or no)			
(organization running log)			
(8) how well bottom plugged PVC plug			
DRILLERS REMARKS:	 DEC 22 1975 MISS. Bd. OF WATER COMMISSIONERS		

