

Panola
 N 200
 1-31-76

MISSISSIPPI
 BOARD OF WATER COMMISSIONERS
 416 North State Street
 Jackson, Mississippi 39201

WATER WELL DRILLERS LOG

1-31 1976 *J B Cain* Panola
 date well completed firm name county well located

LANDOWNER: <i>W. A. Nolan</i>	description of formations encountered	from	to
<i>Rt 1 Sardas Ms</i>			
(mailing address)	<i>Sand</i>	<i>1.5</i>	<i>48</i>


WELL LOCATION:
 sec. 27 T. 8 N R. 6 E
7 miles E of Batesville
 (distance) (direction) (nearest town)

WELL PURPOSE: Home
 (home, irrigation, municipal, industrial)

- WELL COMPLETION DATA:
- (1) diameter (inches) 4 1/2
 - (2) total depth (feet) 48
 - (3) static water level (feet) 30 below above top of ground.
 - (4) casing 4" Plastic 48'
 (material) (depth)
 - No if telescope see back.
 (size)
 - (5) screen 10" 38'
 (length) (depth to top)
4" Plastic
 (size) (material)
 - (6) pump 1/2 12
 (HP) (yield gpm)
Elect
 (type power)
 - (7) electric log NO
 (yes or no)

(organization running log)
 (8) how well bottom plugged Plug


DRILLERS REMARKS: A Cain

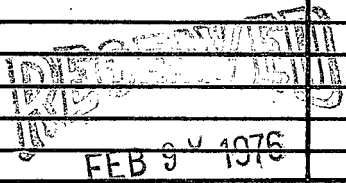

MISS. BD. OF WATER COMMISSIONERS

If well telescopes please sketch and show depths.

GROUND LEVEL

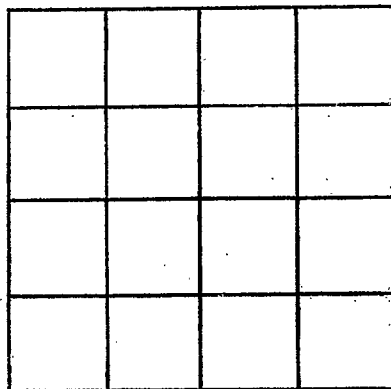

SECTION _____

Please indicate well location X.

ADDITIONAL INFORMATION

If more than one screen, show locations of each on sketch.