

BOARD OF WATER COMMISSIONERS

416 North State Street

Jackson, Mississippi 39201

Parola
N 2805

WATER WELL DRILLERS LOG


Oct 12 19 83 Super Well Supply Parola
date well completed firm name county well located

LANDOWNER: <u>W. Osborne</u>	description of formations encountered	from	to
<u>Rt 4 Box 351</u> <u>Bozerville Ms 38608</u> (mailing address)			
<p>WELL LOCATION:</p> <p>sec. <u>19</u> T. <u>8</u> N. R. <u>6</u> E <u>2</u> miles <u>N</u> of <u>Black Port</u> (distance) (direction) (nearest town)</p> <p>WELL PURPOSE: (home irrigation, municipal, industrial)</p> <p>WELL COMPLETION DATA:</p> <p>(1) diameter (inches) <u>4</u></p> <p>(2) total depth (feet) <u>160</u></p> <p>(3) static water level (feet) <u>82</u> <u>below</u> above top of ground.</p> <p>(4) casing <u>PVC</u> <u>152</u> (material) (depth)</p> <p>(size) if telescope see back.</p> <p>(5) screen <u>8</u> <u>152</u> (length) (depth to top)</p> <p>(size) <u>4</u> (material) <u>PVC</u></p> <p>(6) pump <u>3/4</u> <u>10</u> (HP) (yield gpm)</p> <p>(type power) <u>elec</u></p> <p>(7) electric log <u>no</u> (yes or no)</p> <p>(organization running log)</p> <p>(8) how well bottom plugged <u>PVC cap</u></p> <p>DRILLERS REMARKS:</p>	<p><u>Clay + sand</u> <u>5' - 6'</u></p>	<p><u>0</u></p>	<p><u>40</u> <u>165</u></p>

MISSISSIPPI BUREAU OF LAND & WATER RESOURCES
OCT 17 1983
RECEIVED

If well telescopes please sketch and show depths.

GROUND LEVEL

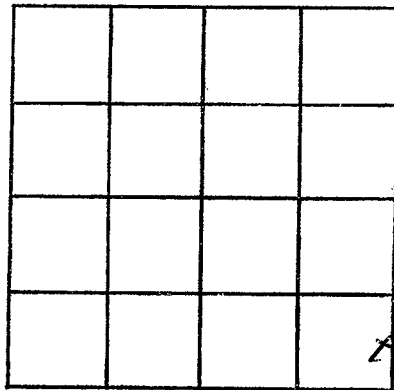

SECTION 19

Please indicate well location X.

ADDITIONAL INFORMATION

If more than one screen, show locations of each on sketch.