

MISSISSIPPI DEPARTMENT OF NATURAL RESOURCES

Bureau of Land and Water Resources

P.O. Box 10631

Jackson, Mississippi 39209

WATER WELL DRILLERS LOG

COUNTY WELL LOCATED <i>Panola</i>	
WELL NUMBER <i>N 2006</i>	CODED
DATE WELL COMPLETED <i>9-3-86</i>	

PERMIT NUMBER
NAME OF DRILLING FIRM <i>90's well Co.</i>

NAME & MAILING ADDRESS OF LANDOWNER <i>Robert West</i>			
<i>207 Virginia St</i>			
<i>Ladonia, MS</i>			
WELL LOCATION:	SEC	TOWNSHIP	RANGE
	<i>P</i>	<i>P</i>	<i>S 6 E</i>
DISTANCE	DIRECTION	NEAREST TOWN	
<i>5</i> Miles	<i>E</i>	of <i>Ladonia</i>	
OTHER LANDMARK			
WELL PURPOSE <input checked="" type="checkbox"/> Home, <input type="checkbox"/> Irrigation, <input type="checkbox"/> Municipal, <input type="checkbox"/> Industrial, <input type="checkbox"/> Fish Pond, etc.			

PUMP DATA		
PUMP TYPE (Circle One): <input checked="" type="checkbox"/> Submersible Turbine, Jet <input checked="" type="checkbox"/> Flowing Well Other (Describe) _____		
POWER TYPE (Circle One): <input checked="" type="checkbox"/> Electric Tractor, Diesel, Gasoline, Butane, Other (Describe) _____		
Pump Capacity (GPM) <i>40</i>	No. of Stages	Setting Depth <i>80</i> FT.
PUMP TEST		
Well yielded <i>40</i> GPM with a drawdown of _____ ft. after _____ hours of pumping		


WELL DATA		
Well Depth <i>155'</i>	Casing Diameter (In.) <i>4"</i>	Casing Length (Ft.) <i>145'</i>
Type of Casing <i>PVC</i>	Hole Depth <i>155'</i>	Depth to Static Water Level <i>0'</i>
TYPE OF COMPLETION: (Circle One or More): <input checked="" type="checkbox"/> Gravel Packed <input type="checkbox"/> Underreamed, <input type="checkbox"/> Telescoped, <input type="checkbox"/> Natural Development, <input type="checkbox"/> Open Hole, <input type="checkbox"/> Other (Describe) _____		
Top of Lap Pipe or Reduction in Casing		
FEET IF TELESCOPED OR MORE THAN ONE SCREEN: USE BACK PAGE		

LOG DATA	
TYPE OF LOG RUN (Circle One): No Log Run, Electric, Gamma Ray, Density, Sonic, Neutron, Other (Describe) _____	
Name of Organization Running Log	

SCREEN DATA		
Diameter - Inches <i>4"</i>	Length - Feet <i>10'</i>	Slot Size - Inches <i>.013</i>
Screen Type <i>PVC</i>	Depth to Bottom - Feet <i>20'</i>	

GEOLOGIC DATA (Office Use Only)			
Surface Elev.	Geologic Unit	Unit Thickness	Depth to Top
Subs. SWL	Date	Analysis	Aquifer Test
Driller's Remarks			

DESCRIPTION OF FORMATIONS ENCOUNTERED	FROM	TO	FROM	TO
<i>red clay</i>	<i>0</i>	<i>10</i>		
<i>red sand</i>	<i>10</i>	<i>30</i>		
<i>black clay</i>	<i>30</i>	<i>120</i>		
<i>white sand</i>	<i>120</i>	<i>155</i>		

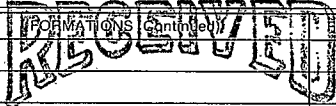


OCT 29 1986

Department of Natural Resources
Bureau of Land & Water Resources

IF MORE SPACE IS NEEDED, USE BACK

If well telescopes please sketch and show depths.

GROUND LEVEL

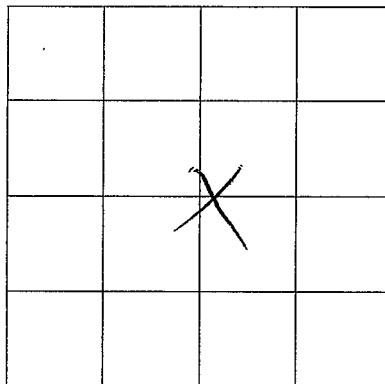

SECTION 5

Please indicate well location X.

ADDITIONAL INFORMATION

If more than one screen,
show location of each on sketch.