

MISSISSIPPI DEPARTMENT OF NATURAL RESOURCES

Bureau of Land and Water Resources

Southport Mall

P.O. Box 10631

Jackson, Mississippi 39209

WATER WELL DRILLERS LOG

PANOLA
N 2008

2 JUNE 1988 19 LIFE WELL & SUPPLY CO PANOLA
date well completed firm name county well located

LANDOWNER: DR. HOWARD ELZEY
ZAB PANOLA PLAZA
BATESVILLE, MS 38606
(mailing address)

WELL LOCATION:
sec. 10 T. 8 N R. 6 E
S W
8 miles SE of SARDIS
(distance) (direction) (nearest town)

WELL PURPOSE: HOME
(home, irrigation, municipal, industrial)

WELL COMPLETION DATA:

(1) diameter (inches) 4"x2"
(2) total depth (feet) 190'
(3) static water level (feet) 3' below above top of ground.
(4) casing PVC 120
(material) (depth)
4 if telescope see back.
(size)
(5) screen 10' 180'
(length) (depth to top)
2" STAINLESS
(size) (material)
(6) pump 1/2 10
(HP) (yield gpm)
230 1Ø
(type power)
(7) electric log NO
(yes or no)
(organization running log)
(8) how well bottom plugged PLUG



description of formations encountered	from	to
TOP SOIL	0	5
SAND W/CLAY	5	20
SAND	20	40
SAND	40	59
ROCK, SANDSTONE	59	60
CLAY	60	62
ROCK, SANDSTONE	62	63
SAND	63	69
ROCK, SANDSTONE	69	70
SAND	70	72
ROCK, SANDSTONE	72	73
BROWN SAND	73	74
SAND STONE W/ SAND	74	82
BROWN SAND W/LIGNITE	82	100
SAND W/CLAY STREAKS	100	115
CLAY	115	125
CLAY W/SAND STREAKS	125	140
SAND W/CLAY & ROCK	140	160
SAND	160	190
CLAY	190	195

RECEIVED
RIS
DEC 21 1988

Department of Natural Resources
Bureau of Land & Water Resources

DRILLERS REMARKS:

If well telescopes please sketch and show depths.

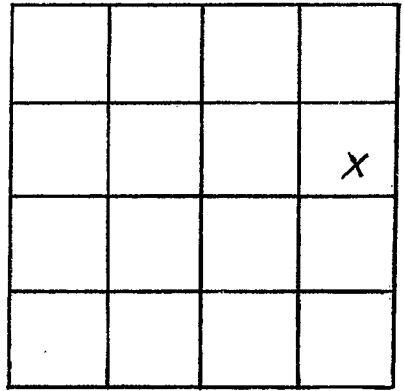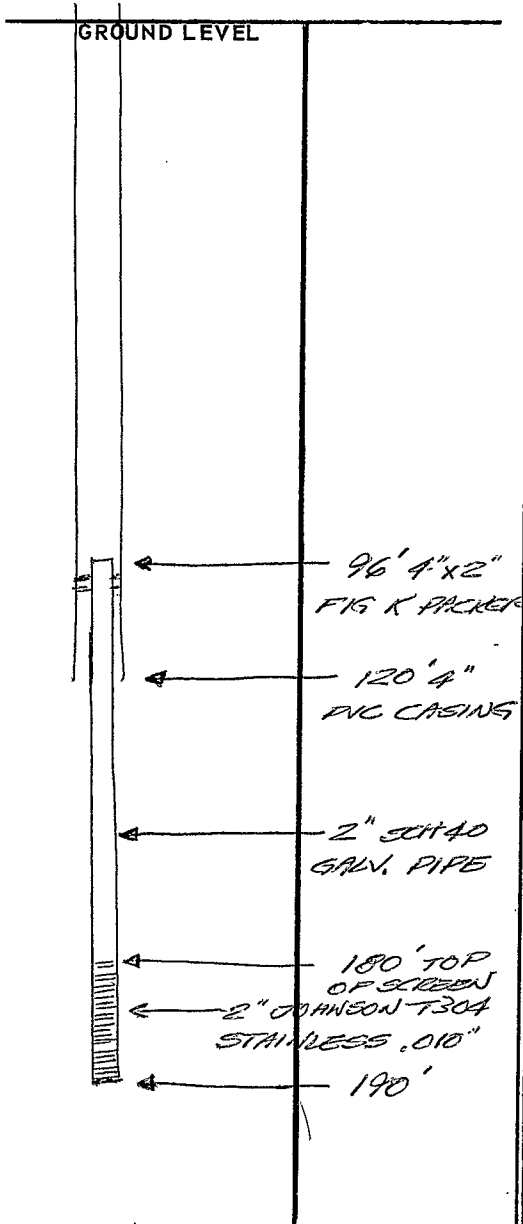

SECTION 10

Please indicate well location X.

ADDITIONAL INFORMATION

If more than one screen,
show locations of each on sketch.