

MISSISSIPPI DEPARTMENT OF NATURAL RESOURCES
Bureau of Land and Water Resources

P.O. Box 10631

Jackson, Mississippi 39209

WATER WELL DRILLERS LOG

COUNTY WELL LOCATED <u>Madison Co.</u>	
WELL NUMBER <u>N 2009</u>	CODED
DATE WELL COMPLETED <u>7-31-89</u>	

PERMIT NUMBER
NAME OF DRILLING FIRM <u>Cain Water Well Serv.</u>
<u>P.O. Box 303 Batesville Miss</u>

NAME & MAILING ADDRESS OF LANDOWNER <u>David Milles</u>			
<u>203 Gordon St</u>			
<u>Batesville Ms 39006</u>			
WELL LOCATION:	SEC <u>31</u>	TOWNSHIP <u>8 N</u>	RANGE <u>6 E</u>
DISTANCE <u>4</u> Miles	DIRECTION <u>N-E</u>	NEAREST TOWN of <u>Batesville</u>	
OTHER LANDMARK			
WELL PURPOSE: Home, Irrigation, Municipal, Industrial, Fish Pond, etc. <u>Home</u>			

PUMP DATA			
PUMP TYPE (Circle One): <input checked="" type="checkbox"/> Submersible, Turbine, Jet, Flowing Well, Other (Describe) _____			
POWER TYPE (Circle One): <input checked="" type="checkbox"/> Electric, Tractor, Diesel, Gasoline, Butane, Other (Describe) _____			
Pump Capacity (GPM) <u>10</u>	No. of Stages <u>11</u>	Setting Depth <u>40</u>	FT.
PUMP TEST			
Well yielded <u>10</u> GPM with a drawdown of _____ ft. after _____ hours of pumping			

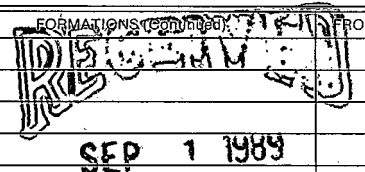
WELL DATA		
Well Depth <u>50 ft</u>	Casing Diameter (In.) <u>4"</u>	Casing Length (Ft.)
Type of Casing <u>Pvc</u>	Hole Depth <u>50 ft</u>	Depth to Static Water Level <u>20 ft</u>
TYPE OF COMPLETION: (Circle One or More): <input checked="" type="checkbox"/> Gravel Packed, <input type="checkbox"/> Underreamed, <input type="checkbox"/> Telescoped, <input checked="" type="checkbox"/> Natural Development, <input type="checkbox"/> Open Hole, <input type="checkbox"/> Other (Describe) _____		
Top of Lap Pipe or Reduction in Casing <u>FEET</u>		
IF TELESCOPED OR MORE THAN ONE SCREEN: USE BACK PAGE		

LOG DATA	
TYPE OF LOG RUN (Circle One): <input checked="" type="checkbox"/> No Log Run, Electric, Gamma Ray, Density, Sonic, Neutron, Other (Describe) _____	
Name of Organization Running Log	

SCREEN DATA		
Diameter - Inches <u>4"</u>	Length - Feet <u>10'</u>	Slot Size - Inches <u>.013</u>
Screen Type <u>Pvc</u>	Depth to Bottom - Feet <u>50</u>	

GEOLOGIC DATA (Office Use Only)			
Surface Elev.	Geologic Unit	Unit Thickness	Depth to Top
Subs. SWL	Date	Analysis	Aquifer Test

Driller's Remarks <u>Austin Cain Driller</u>
<u>Licens No 0-434 Ms.</u>

DESCRIPTION OF FORMATIONS ENCOUNTERED	FROM	TO	FORMATIONS (continued)	FROM	TO
<u>Clay</u>	<u>0</u>	<u>12</u>			
<u>Gravel</u>	<u>12</u>	<u>15</u>			
<u>White Clay And Sand</u>	<u>15</u>	<u>37</u>			
<u>Water Sand</u>	<u>37</u>	<u>50</u>			
			<u>SEP 1 1989</u>		
			Department of Natural Resources Bureau of Land & Water Resources		
			IF MORE SPACE IS NEEDED, USE BACK		

If well telescopes please sketch and show depths.

GROUND LEVEL

X			

SECTION 31

Please indicate well location X.

ADDITIONAL INFORMATION

If more than one screen,
show location of each on sketch.