

0

1-6-66

WATER WELL DRILLERS LOG

Date: 1-6, 1966, Driller: Jerry Roberson County Panola (Name)

(1) Owner of Land: M. Yarnal (Name)

Batemville, Miss. (Address)

(2) Location: 1/4, 1/4, Sec. T R

15 miles E, of B'ville (distance) (direction) (Nearest Town)

(3) Topography: V (Hilly) (Flat) (Level)

(4) Purpose of Well: Home (Domestic Irrigation Municipal, Industrial, Other)

Description & Color of Materials Sand, Clay, Red Clay, Shell, etc.

Thick-ness Feet

Depth Feet

Clay 0 30 Sand & Clay 30 50 Sand 50 95

Information upon completion of well:

(1) Diameter 2 inches.

(2) Total Depth 95 feet.

(3) Water Level 45 feet below top of ground.

(4) Cased to 90, Size 2 in

(5) Screen: Size 3 in, Length 5 ft

(6) Were any formations sealed against pollution?


yes, no.

If YES depth of formation

Why

Drillers Remarks: Plastic Well

outside screen

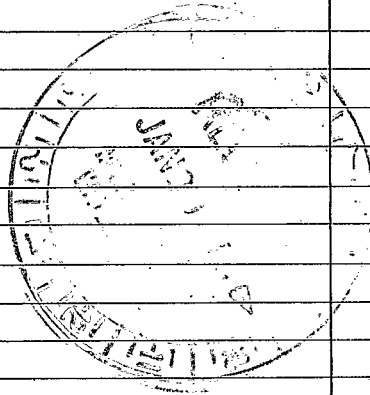

(Use Back Side)

Well No.

