

CODED

Panola
02
8-68

MISSISSIPPI
BOARD OF WATER COMMISSIONERS
416 North State Street
Jackson, Mississippi 39201

WATER WELL DRILLERS LOG

8-12-68 19 Paulk Brothers Panola
date well completed firm name county well located

LANDOWNER: George Johnson

description of formations encountered from to

RFD

Sardis, Miss.
(mailing address)

Top Soil 0 3'
Silty clay 3 12
Fine Sand 12 18

WELL LOCATION:
sec. 32 T. 8 N. R. 5 W.
S W
12 miles E of Batesville
(distance) (direction) (nearest town)

WELL PURPOSE: Home
(home, irrigation, municipal, industrial)

WELL COMPLETION DATA:

- (1) diameter (inches) 1 1/4"
- (2) total depth (feet) 18'
- (3) static water level (feet) 8' ^{below} ~~above~~ top of ground.
- (4) casing Steel, 12'
(material), (depth)
1 1/4"
(size) if telescope see back.
- (5) screen 6', 12'
(length), (depth to top)
1 1/4", Brass
(size), (material)
- (6) pump 1/3, 7
(HP), (yield gpm)
Electric
(type power)
- (7) electric log No
(yes or no)

(organization running log)


(8) how well bottom plugged Drive Point

DRILLERS REMARKS:

CODED

If well telescopes please sketch and show depths.

GROUND LEVEL

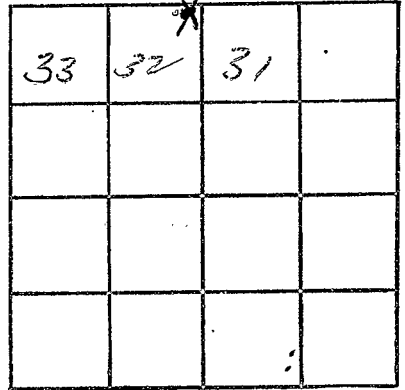

33	32*	31	

SECTION 32

Please indicate well location X.

ADDITIONAL INFORMATION

If more than one screen, show locations of each on sketch.