

Panola  
05  
6-69

MISSISSIPPI  
 BOARD OF WATER COMMISSIONERS  
 416 North State Street  
 Jackson, Mississippi 39201

WATER WELL DRILLERS LOG

6-12- 1969 Bob Smith Panola  
 date well completed firm name county well located

LANDOWNER:	description of formations encountered	from	to
<u>A. Edwine</u>			
<u>Sardis Miss.</u> (mailing address)	<u>top soil</u>	<u>0</u>	<u>5</u>
	<u>red clay</u>	<u>5</u>	<u>30</u>
	<u>red sand</u>	<u>30</u>	<u>20</u>
	<u>white sand</u>	<u>20</u>	<u>20</u>
WELL LOCATION: sec <u>20</u> T <u>8</u> N R <u>SE</u> <u>1/4</u> <u>2</u> <u>ARE</u> <u>6</u> miles <u>S</u> of <u>Sardis</u> (distance) (direction) (nearest town)			
WELL PURPOSE: <u>Home</u> (home, irrigation, municipal, industrial)			
WELL COMPLETION DATA:			
(1) diameter (inches) <u>4</u>			
(2) total depth (feet) <u>190</u>			
(3) static water level (feet) <u>140</u> <sup>below</sup> / <sub>above</sub> top of ground			
(4) casing <u>Plastic</u> <u>190</u> (material) (depth)			
(size) if telescope see back.			
(5) screen <u>20</u> <u>170</u> (length) (depth to top)			
<u>4</u> <u>Plastic</u> (size) (material)			
(6) pump <u>1/2</u> <u>10</u> (HP) (yield gpm)			
<u>Electric</u> (type power)			
(7) electric log <u>no</u> (yes or no)			
(organization running log)			
(8) how well bottom plugged <u>plugged</u>			


RECEIVED  
 JUN 11 1969  
 MISSISSIPPI BOARD OF WATER COMMISSIONERS

DRILLERS REMARKS:

good drilling

If well telescopes please sketch and show depths.

GROUND LEVEL

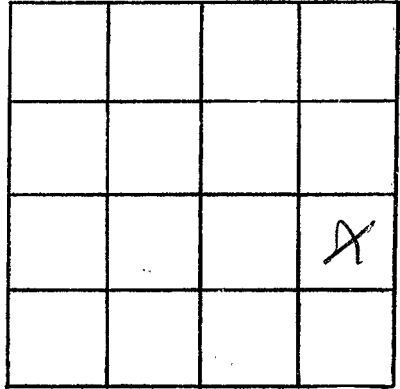

SECTION 28

Please indicate well location X.

ADDITIONAL INFORMATION

If more than one screen, show locations of each on sketch.