

Panola
 014
 7-68

MISSISSIPPI
 BOARD OF WATER COMMISSIONERS
 416 North State Street
 Jackson, Mississippi 39201

WATER WELL DRILLERS LOG

CODED

7-5 1968 date well completed
 J B Cain firm name
 Panola county well located

LANDOWNER: JB KLINE
Sardis
Miss
 (mailing address)

description of formations encountered	from	to
<i>Top of</i>	0	30
<i>Brk Shaly Clay</i>	30	140
<i>Sand</i>	140	200

WELL LOCATION:
 sec. 30 T 8 N R. 5 E
 SW SE NW
10 miles E of Sardis
 (distance) (direction) (nearest town)

WELL PURPOSE: Home
 (home, irrigation, municipal, industrial)

- WELL COMPLETION DATA:
- (1) diameter (inches) 4"
 - (2) total depth (feet) 200
 - (3) static water level (feet) 126 below top of ground.
 - (4) casing Plastic, 200
 (material) (depth)
4
 (size) if telescope see back.
 - (5) screen 5, 195
 (length) (depth to top)
3, Silty Pack
 (size) (material)
 - (6) pump 3/4 12
 (HP) (yield gpm)
Electric
 (type power)
 - (7) electric log NO
 (yes or no)
 - (8) how well bottom plugged _____
 (organization running log)


CODED

JUL 27 1968
 MISS. BOARD OF
 WATER COMMISSIONERS

DRILLERS REMARKS: _____

If well telescopes please sketch and show depths.

GROUND LEVEL

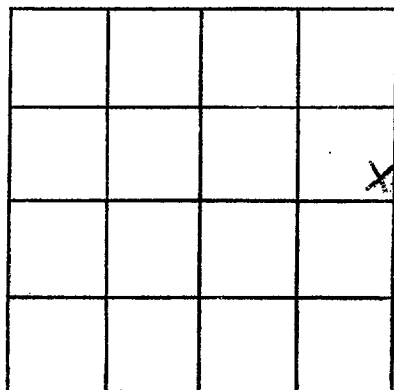

SECTION 30

Please indicate well location X.

ADDITIONAL INFORMATION

If more than one screen, show locations of each on sketch.