

Panola
015
7-68

MISSISSIPPI
 BOARD OF WATER COMMISSIONERS
 416 North State Street
 Jackson, Mississippi 39201

CODED

WATER WELL DRILLERS LOG

7/13 19 68 Bob Smith Panola
 date well completed firm name county well located

LANDOWNER: Woodard

description of formations encountered	from	to
<u>Top Soil</u>	<u>0</u>	<u>10</u>
<u>red Clay</u>	<u>10</u>	<u>40</u>
<u>red Sand</u>	<u>40</u>	<u>60</u>
<u>white clay</u>	<u>60</u>	<u>100</u>
<u>whil. Sand</u>	<u>100</u>	<u>220</u>

Sardis, Miss
 (mailing address)


WELL LOCATION:
 sec. 29 T. 8 N. R. 5 E
1 1/2 miles East of SARDIS
 (distance) (direction) (nearest town)

WELL PURPOSE: home
 (home, irrigation, municipal, industrial)

WELL COMPLETION DATA:

- (1) diameter (inches) 4 ~~2 1/2~~
- (2) total depth (feet) 220
- (3) static water level (feet) 120 below above top of ground.
- (4) casing plastic 220
 (material) (depth)
 (size) if telescope see back.
- (5) screen 20 200
 (length) (depth to top)
4 plastic
 (size) (material)
- (6) pump 3/4 10
 (HP) (yield gpm)
Elec
 (type power)
- (7) electric log no
 (yes or no)
 (organization running log)
- (8) how well bottom plugged plugged


CODED

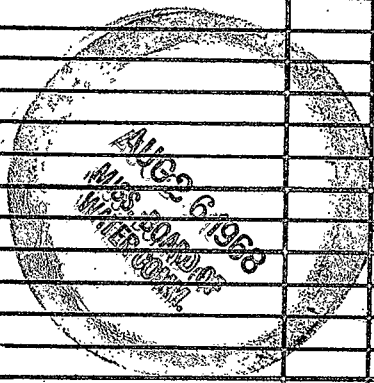

DRILLERS REMARKS:
good drilling

If well telescopes please sketch and show depths.

GROUND LEVEL

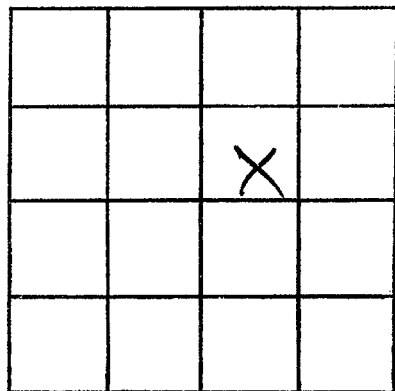

SECTION _____

Please indicate well location X.

ADDITIONAL INFORMATION

If more than one screen, show locations of each on sketch.