

PANOLA
 Ø 16
 1-5-73

MISSISSIPPI
 BOARD OF WATER COMMISSIONERS
 416 North State Street
 Jackson, Mississippi 39201

CODED

WATER WELL DRILLERS LOG

Jan 5 1973 J. B. Cain Panola
 date well completed firm name county well located

LANDOWNER:

Mr. Johnny

(mailing address)

WELL LOCATION:

sec. 33 T 8 N R 8 E
 13 miles SE of Batesville
 (distance) (direction) (nearest town)

WELL PURPOSE:

(home, irrigation, municipal, industrial)

WELL COMPLETION DATA:

- (1) diameter (inches) 4"
- (2) total depth (feet) 150
- (3) static water level (feet) 90 below top of ground.
- (4) casing PLASTIC 150 (material) (depth)
- (size) If telescope see back.
- (5) screen 10' 140 (length) (depth to top)
- 4" PLASTIC (size) (material)
- (6) pump 34 11 (HP) (yield gpm)
- Electric (type power)
- (7) electric log no (yes or no)

(organization running log)

- (8) how well bottom plugged Plug

description of formations encountered

from

to

Brown Clay 0 20
 Blue Clay 20 120
 MCLAY SAND 120 150

CODED

DRILLERS REMARKS:


JUN 11 1973

30. OF

NUMBER

If well telescopes please sketch and show depths.

GROUND LEVEL

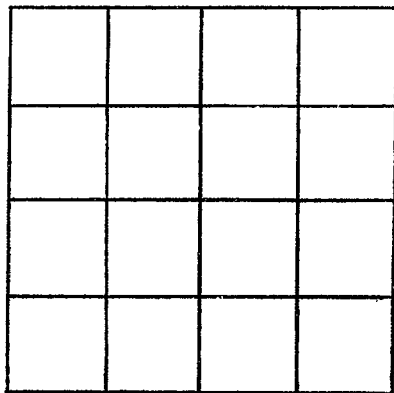

SECTION _____

Please indicate well location X.

ADDITIONAL INFORMATION

If more than one screen, show locations of each on sketch.