

PANOLA
 19
 3-4-74

MISSISSIPPI
 BOARD OF WATER COMMISSIONERS
 416 North State Street
 Jackson, Mississippi 39201

CODED

WATER WELL DRILLERS LOG

3-4 1974 Life well Co. Panola
 date well completed firm name county well located

LANDOWNER:	description of formations encountered	from	to
George Acree Jr.	Top soil	0	20
Batesville Miss.	red sand	20	40
(mailing address)	" "	40	60
	black clay	60	80
	" "	80	100
	" "	100	120
	sand and clay	120	140
	white sand	140	160
	" "	160	180

WELL LOCATION:
 sec. 9 T. 8 N. R. 5 E.
 10 miles S.E. of Batesville
 (distance) (direction) (nearest town)

WELL PURPOSE:
 home irrigation, municipal, industrial

WELL COMPLETION DATA:

(1) diameter (inches) 4"
 (2) total depth (feet) 180
 (3) static water level (feet) 90 below top of ground.
 (4) casing PVC 170 (material) (depth)
 4 If telescope see back. (size)
 (5) screen 10 170 (length) (depth to top)
 4 PVC (size) (material)
 (6) pump 3/4 10 (HP) (yield gpm)
 elec. (type power)
 (7) electric log no (yes or no)
 no (organization running log)
 (8) how well bottom plugged PVC plug


DRILLERS REMARKS:

MISS. Bd. OF WATER COMMISSIONERS

APR - 3 1974

If well telescopes please sketch and show depths.

GROUND LEVEL

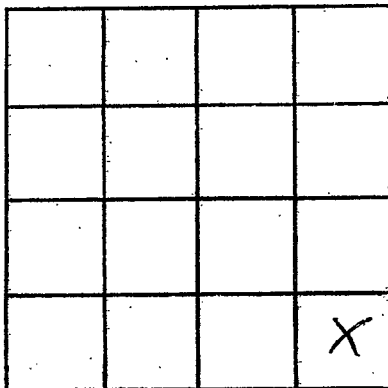

SECTION 9

Please indicate well location X.

ADDITIONAL INFORMATION

If more than one screen,
show locations of each on sketch.