

PANOLA

(1) 21

2-4-79

MISSISSIPPI
 BOARD OF WATER COMMISSIONERS
 416 North State Street
 Jackson, Mississippi 39201

CODED

WATER WELL DRILLERS LOG

2-4-79 date well completed 1979 Bob Smith firm name Panola county well located

LANDOWNER:
 Joe Patterson
 Sardin, Miss.
 (mailing address)

description of formations encountered	from	to
Top soil	0'	5'
Red sand	5'	80'
Blue clay	80'	120'
sand	120'	220'

WELL LOCATION:
 sec. 19 T-8 N R-5 E
 S W
 15 miles NE of Batesville
 (distance) (direction) (nearest town)

WELL PURPOSE: Home
 (home, irrigation, municipal, industrial)

WELL COMPLETION DATA:

(1) diameter (inches) 4
 (2) total depth (feet) 220
 (3) static water level (feet) 135 below top of ground.
 (4) casing Plastic 220
 (material) (depth)
 (size) if telescope see back.
 (5) screen 20 300
 (length) (depth to top)
 4 Plastic
 (size) (material)
 (6) pump 1/2 10
 (HP) (yield gpm)
 Elec.
 (type power)
 (7) electric log no
 (yes or no)
 (organization running log)
 (8) how well bottom plugged plugged


CODED

DRILLERS REMARKS:

MISS. Bd. OF WATER COMMISSIONERS
 JAN 7 1979

If well telescopes please sketch and show depths.

GROUND LEVEL

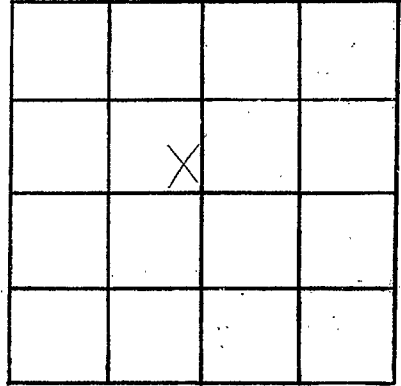

SECTION 19

Please indicate well location X.

ADDITIONAL INFORMATION

If more than one screen, show locations of each on sketch.