

PANOLA

Ø 22

8-27-74

MISSISSIPPI BOARD OF WATER COMMISSIONERS

416 North State Street

Jackson, Mississippi 39201 CODED

WATER WELL DRILLERS LOG

8-27
date well completed

1974 Life Well Co

firm name

Panola

county well located

LANDOWNER:

Gladden Russell

Batesville Miss,

(mailing address)

description of formations encountered

from

to

Top soil

0 20

red clay

20 40

sand

40 60

blue clay

60 80

sand and clay

80 100

clay

100 120

clay

120 140

sand

140 180

WELL LOCATION:

sec 28 T 8 N R 6 E
12 miles east of Batesville
(distance) (direction) (nearest town)

WELL PURPOSE:

(home) irrigation, municipal, industrial

WELL COMPLETION DATA:

- (1) diameter (inches) 4
- (2) total depth (feet) 180
- (3) static water level (feet) 90 below above top of ground.
- (4) casing PVC 170 (material) (depth), 4 (size) if telescope see back.
- (5) screen 10 170 (length) (depth to top), 14 (size) PVC (material)
- (6) pump 3/4 10 (HP) (yield gpm), C125 (type power)
- (7) electric log NO (yes or no), NO (organization running log)
- (8) how well bottom plugged PVC 108


DRILLERS REMARKS:

RECEIVED
SEP 5 1974

MISS. Bd. OF WATER COMMISSIONERS

If well telescopes please sketch and show depths.

GROUND LEVEL

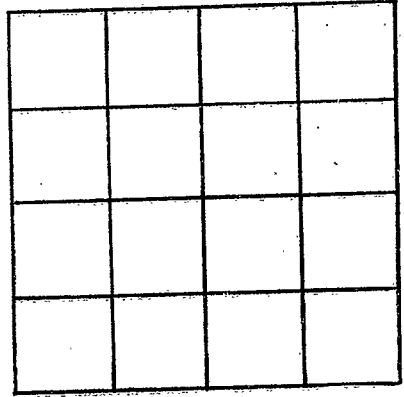

SECTION _____

Please indicate well location X.

ADDITIONAL INFORMATION

If more than one screen,
show locations of each on sketch.