

PANOLA
 Q23
 10-19-74

MISSISSIPPI
 BOARD OF WATER COMMISSIONERS
 416 North State Street
 Jackson, Mississippi 39201

CODED

WATER WELL DRILLERS LOG

10-14 date well completed 1974 Lippe Well Co. firm name Panola county well located

LANDOWNER:
 Pervis Allen
 Batesville Miss.
 (mailing address)

description of formations encountered	from	to
TOP SOIL	0	20
Red Sand	20	40
CLAY	40	60
SAND	60	80
	80	100
	100	118

WELL LOCATION:
 sec. 32 T 8 N R 5 E
 8 miles EAST of Batesville
 (distance) (direction) (nearest town)


WELL PURPOSE:
 (home, irrigation, municipal, industrial)

- WELL COMPLETION DATA:
- (1) diameter (inches) 4
 - (2) total depth (feet) 118
 - (3) static water level (feet) 50 below top of ground.
 - (4) casing PVC 108 (material) (depth)
 4 (size) if telescope see back.
 - (5) screen 10 108 (length) (depth to top)
 4 PVC (size) (material)
 - (6) pump 3/4 10 (HP) (yield gpm)
 elec. (type power)
 - (7) electric log NO (yes or no)
 NO (organization running log)
 - (8) how well bottom plugged PVC CAP

RECEIVED
 NOV - 4 1974

If well telescopes please sketch and show depths.

GROUND LEVEL

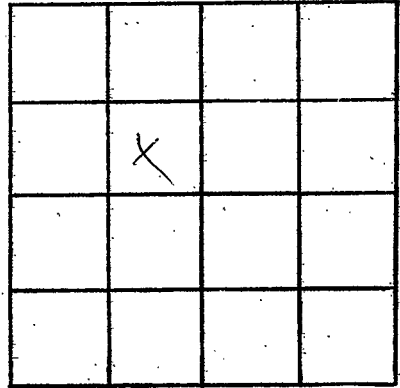

SECTION 32

Please indicate well location X.

ADDITIONAL INFORMATION

If more than one screen,
show locations of each on sketch.