

PANOLA
Q 24
10-17-74

MISSISSIPPI
BOARD OF WATER COMMISSIONERS
416 North State Street
Jackson, Mississippi 39201

CODED

WATER WELL DRILLERS LOG

10-17 date well completed 1974 Lipe Well Co. firm name Panola county well located

LANDOWNER:
Robert Durham
Batesville Miss.
(mailing address)

description of formations encountered	from	to
TOP SOIL	0	20
red sand	20	40
blue clay	40	60
" "	60	80
" "	80	100
" "	100	120
Sand and clay	120	140
SAND	140	160

WELL LOCATION:
sec. 29 T 08 N R 5 E
10 miles east of Batesville
(distance) (direction) (nearest town)

WELL PURPOSE:
(home, irrigation, municipal, industrial)

WELL COMPLETION DATA:


- (1) diameter (inches) 4
- (2) total depth (feet) 160
- (3) static water level (feet) 80 below top of ground.
- (4) casing PVC 150 (material) (depth)
4 (size) If telescope see back.
- (5) screen 10 150 (length) (depth to top)
4 PVC (size) (material)
- (6) pump 3/4 10 (HP) (yield gpm)
elec (type power)
- (7) electric log no (yes or no)
no (organization running log)
- (8) how well bottom plugged PVC CAP

RECEIVED
NOV - 4 1974

DRILLERS REMARKS:

If well telescopes please sketch and show depths.

GROUND LEVEL

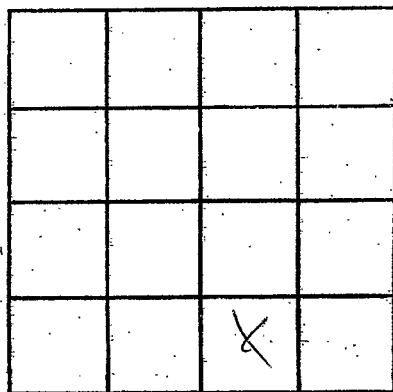

SECTION 29

Please indicate well location X.

ADDITIONAL INFORMATION

If more than one screen,
show locations of each on sketch.