

PANOLA
 #25
 5-12-74

MISSISSIPPI
 BOARD OF WATER COMMISSIONERS
 416 North State Street
 Jackson, Mississippi 39201

CODL CODED

WATER WELL DRILLERS LOG

5-12-1974 W.C. Mason Panola
 date well completed firm name county well located

LANDOWNER:
 George E. Brown
 RFD - Sardis Miss.
 (mailing address)

description of formations encountered	from	to
clay silt	0	6
yellow sand	6	100

WELL LOCATION:
 sec. 32 T. 8 N. R. 5 E.
 10 1/2 miles East of Batesville
 (distance) (direction) (nearest town)

WELL PURPOSE: None
 (home, irrigation, municipal, industrial)

CODED

- WELL COMPLETION DATA:
- (1) diameter (inches) 4"
 - (2) total depth (feet) 100'
 - (3) static water level (feet) 37' below top of ground.
 - (4) casing Plastic, 90' (material) (depth)
 4" (size) If telescope see back.
 - (5) screen 10' 90' (length) (depth to top)
 4" Plastic (size) (material)
 - (6) pump 1/3 7 (HP) (yield gpm)
 electric (type power)
 - (7) electric log No (yes or no)
- (organization running log)
- (8) how well bottom plugged cap


RECEIVED
 DEC 27 1974

DRILLERS REMARKS:

MISS. RD. OF WATER COMMISSIONERS

If well telescopes please sketch and show depths.

GROUND LEVEL

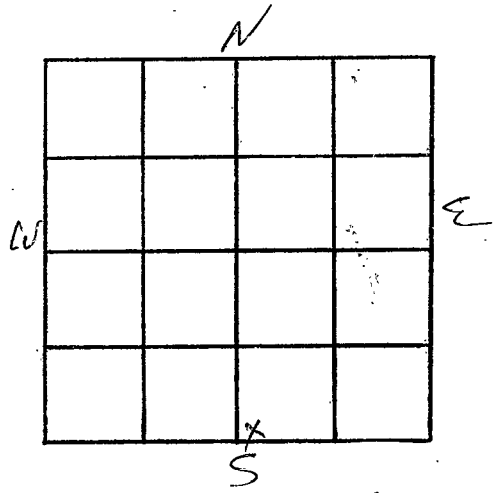

SECTION 32

Please indicate well location X.

ADDITIONAL INFORMATION

If more than one screen, show locations of each on sketch.