

PANOLA  
 26  
 4-4-74

MISSISSIPPI  
 BOARD OF WATER COMMISSIONERS  
 416 North State Street  
 Jackson, Mississippi 39201

CODED

WATER WELL DRILLERS LOG

4-4-1974 W.A. Mason Panola  
 date well completed firm name county well located

LANDOWNER:  
 Jerry Perkins  
 RFD, Sardis Miss.  
 (mailing address)

description of formations encountered	from	to
clay dirt	0	6
yellow sand	6	100

WELL LOCATION:  
 sec. 32 T 8 N R 5 E  
 10 1/2 miles East of Beterid  
 (distance) (direction) (nearest town)

WELL PURPOSE: Home  
 (home, irrigation, municipal, industrial)

- WELL COMPLETION DATA:
- (1) diameter (inches) 4"
  - (2) total depth (feet) 100'
  - (3) static water level (feet) 37' below top of ground.
  - (4) casing Plastic 90'  
 (material) (depth)  
4" if telescope see back.  
 (size)
  - (5) screen 10' 90'  
 (length) (depth to top)  
4" Plastic  
 (size) (material)
  - (6) pump 3/4 10  
 (HP) (yield gpm)  
electric  
 (type power)
  - (7) electric log No  
 (yes or no)
  - (8) how well bottom plugged cap

CODED

RECEIVED  
 RECEIVED


DEC 27 1974

DRILLERS REMARKS:

MISS. RD. OF WATER COMM

If well telescopes please sketch and show depths.

GROUND LEVEL

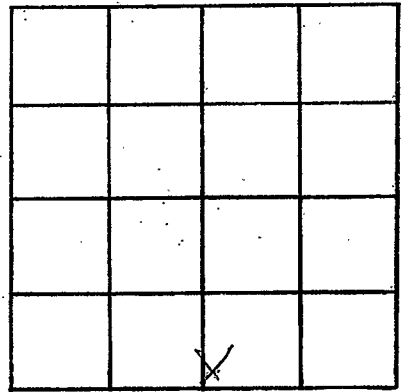

SECTION 32

Please indicate well location X.

ADDITIONAL INFORMATION

If more than one screen, show locations of each on sketch.