

Panola
 Ø 27
 12-3-74

MISSISSIPPI
 BOARD OF WATER COMMISSIONERS
 416 North State Street
 Jackson, Mississippi 39201

CODED

WATER WELL DRILLERS LOG

12-3 date well completed 1974 T & E Well Co. firm name Panola county well located

LANDOWNER:	description of formations encountered	from	to
Marvin Ray	Topsoil	0	20
Batesville Miss.	red sand	20	40
(mailing address)	" "	40	60
	white clay	60	80
	sand and clay	80	100
	" "	100	120
	blue clay	120	140
	sand	140	160
	white sand	160	176

LANDOWNER:

description of formations encountered

from

to

WELL LOCATION:

sec 33 T 8 N R 5 E
 6 miles west of Oxford
 (distance) (direction) (nearest town)

WELL PURPOSE:

(home) Irrigation, municipal, industrial

WELL COMPLETION DATA:

- (1) diameter (inches) 4
- (2) total depth (feet) 176
- (3) static water level (feet) 110 below top of ground
- (4) casing PVC 166 (material) (depth)
- 4 (size) If telescope see back.
- (5) screen 10 166 (length) (depth to top)
- 4 PVC (size) (material)
- (6) pump 3/4 10 (HP) (yield gpm)
- elec. (type power)
- (7) electric log No (yes or no)
- No (organization running log)
- (8) how well bottom plugged PVC cap

CODED

RECEIVED


DEC 31 1974

DRILLERS REMARKS:

MRS. B.D. ... R ...

If well telescopes please sketch and show depths.

GROUND LEVEL

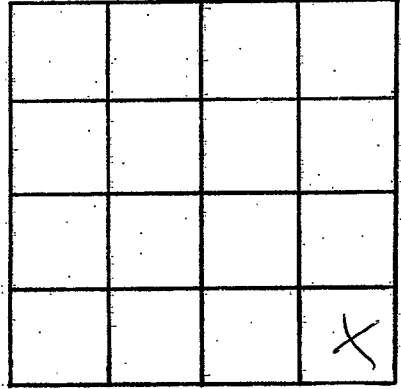

SECTION 33

Please indicate well location X.

ADDITIONAL INFORMATION

If more than one screen,
show locations of each on sketch.