

Panola
 Ø 28
 12-9-74

MISSISSIPPI
 BOARD OF WATER COMMISSIONERS
 416 North State Street
 Jackson, Mississippi 39201

CODED

WATER WELL DRILLERS LOG

12-9 1974 Life Well Co. Panola
 date well completed firm name county well located

LANDOWNER:	description of formations encountered	from	to
Fred Kaufman	Top soil	0	20
Batesville Miss. (mailing address)	red sand	20	40
	" " "	40	60
	blue clay	60	80
	sand and clay	80	100
	" " "	100	120
	sand	120	150
WELL LOCATION: sec. 19 T. 8 N. R. 5 E. 8 miles east of Batesville (distance) (direction) (nearest town)			
WELL PURPOSE: (home) irrigation, municipal, industrial			
WELL COMPLETION DATA:			
(1) diameter (inches) 4			
(2) total depth (feet) 150			
(3) static water level (feet) 100 below top of ground.			
(4) casing PVC 140 (material) (depth)			
4 (size) if telescope see back.			
(5) screen 10 140 (length) (depth to top)			
4 PVC (size) (material)			
(6) pump 3/4 10 (HP) (yield gpm)			
elec. (type power)			
(7) electric log no (yes or no)			
no (organization running log)			
(8) how well bottom plugged PVC CAP			
DRILLERS REMARKS:			

CODED


RECEIVED

DEC 31 1974

MISS. BD. OF WATER COMMISSIONERS

If well telescopes please sketch and show depths.

GROUND LEVEL

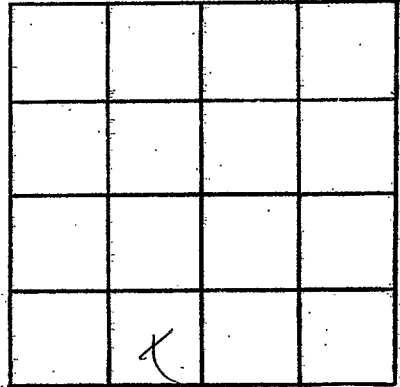

SECTION 19

Please indicate well location X.

ADDITIONAL INFORMATION

If more than one screen, show locations of each on sketch.