

PANOLA

079

3-16-75

MISSISSIPPI BOARD OF WATER COMMISSIONERS
416 North State Street
Jackson, Mississippi 39201

CODED

WATERWELL DRILLERS LOG

3-16-95

date well completed

Big Sheen
J B Co firm name
Panola county well located

LANDOWNER: *J Mills*

Batesville Ms

(mailing address)

description of formations encountered

from to

Sand Clay St 0 170

Water Sand 170 180

WELL LOCATION:

sec *31* T *8* N R *5* E
10 miles *E* of *Batesville*
(distance) (direction) (nearest town)

WELL PURPOSE:

(home, irrigation, municipal, industrial)

WELL COMPLETION DATA:

- (1) diameter (inches) *4"*
- (2) total depth (feet) *170*
- (3) static water level (feet) *160* below top of ground
- (4) casing *Plastic* *180*
(material) (depth)
4" if telescope see back.
(size)
- (5) screen *10'* *170*
(length) (depth to top)
4" *Plastic*
(size) (material)
- (6) pump *3/4* *8*
(HP) (yield gpm)
Elect
(type power)
- (7) electric log *no*
(yes or no)

(organization running log)

(8) how well bottom plugged *Plug*


DRILLERS REMARKS:

RECEIVED
APR 24 1975

MISS. BD. OF WATER COMMISSIONERS

If well telescopes please sketch and show depths.

GROUND LEVEL

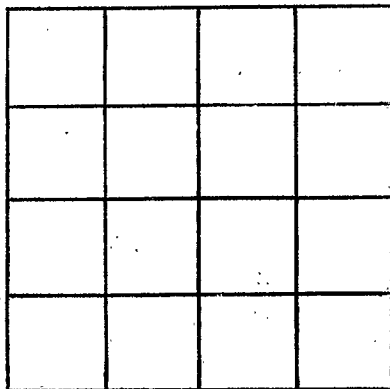

SECTION _____

Please indicate well location X.

ADDITIONAL INFORMATION

If more than one screen, show locations of each on sketch.