

Parola
Φ 31
11-21-74

MISSISSIPPI
 BOARD OF WATER COMMISSIONERS
 416 North State Street
 Jackson, Mississippi 39201

WATER WELL DRILLERS LOG

CODED

11/21
 date well completed

1974 Bah Smith Well Drilling
 firm name

Parola
 county well located

LANDOWNER: Don McGehee
Sardis Lake
Batesville, Miss.
 (mailing address)

description of formations encountered

from

to

red sand	0'	40'
2' rock-gray sand & clay	42'	120'
fine sand	120'	160'
tabular sand	160'	236'

WELL LOCATION:

sec. 30 T. 8 N. R. 5 E. 15F
 S. 6 miles NE of Sardis
 (distance) (direction) (nearest town)
road behind dam

WELL PURPOSE:

Home
 (home, irrigation, municipal, industrial)

WELL COMPLETION DATA:

- (1) diameter (inches) 4"
- (2) total depth (feet) 236'
- (3) static water level (feet) 98' below above top of ground.
- (4) casing plastic, 236'
 (material) (depth)
 (size) if telescope see back.
- (5) screen 10', 226'
 (length) (depth to top)
4", plastic
 (size) (material)
- (6) pump 1/2, 12
 (HP) (yield gpm)
electric
 (type power)
- (7) electric log no
 (yes or no)

(organization running log)

- (8) how well bottom plugged plugged

CODED


RECEIVED
 AUG 4 1975

DRILLERS REMARKS:

MISS. RD. OF WATER COMM.

If well telescopes please sketch and show depths.

GROUND LEVEL

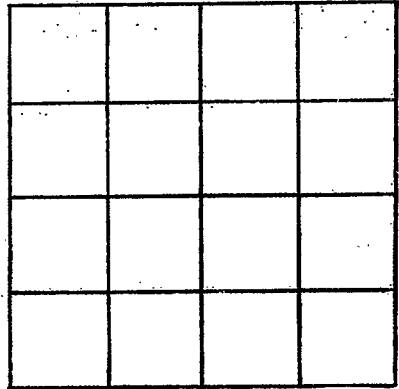

SECTION _____

Please indicate well location X.

ADDITIONAL INFORMATION

If more than one screen, show locations of each on sketch.