


Panola  
32  
1-9-75

MISSISSIPPI  
 BOARD OF WATER COMMISSIONERS  
 416 North State Street  
 Jackson, Mississippi 39201 **CODED**

WATER WELL DRILLERS LOG


Jan. 9 1975 Bob Smith Well Drilling Panola  
 date well completed firm name county well located

| LANDOWNER:   | description of formations encountered | from        | to          |
|--|---------------------------------------|-------------|-------------|
| <u>James Ratliff</u>   |                                       |             |             |
| <u>M.E. Ratliff - Ole Miss Valley</u>  | <u>top soil</u>                       | <u>0'</u>   | <u>20'</u>  |
| <u>Oxford, Miss.</u><br>(mailing address)                                    | <u>red sand</u>                       | <u>20'</u>  | <u>60'</u>  |
| WELL LOCATION:<br>sec. <u>30</u> T. <u>8</u> N. R. <u>5</u> E <sup>15F</sup> | <u>small rock &amp; clay</u>          | <u>60'</u>  | <u>100'</u> |
| <u>6</u> miles <u>NE</u> of <u>Jardis</u>                                    | <u>fine sand</u>                      | <u>100'</u> | <u>200'</u> |
| (distance) (direction) (nearest town)  | <u>CODED</u>                          | <u>200'</u> | <u>245'</u> |
| WELL PURPOSE: <u>None</u><br>(home, irrigation, municipal, industrial)       |                                       |             |             |
| WELL COMPLETION DATA:  |                                       |             |             |
| (1) diameter (inches) <u>4"</u>  |                                       |             |             |
| (2) total depth (feet) <u>245'</u>   |                                       |             |             |
| (3) static water level (feet) <u>119</u> below top of ground.                |                                       |             |             |
| (4) casing <u>plastic</u> , <u>245'</u><br>(material) (depth)                |                                       |             |             |
| (size) If telescope see back.  |                                       |             |             |
| (5) screen <u>20'</u> , <u>225'</u><br>(length) (depth to top)               |                                       |             |             |
| <u>4"</u> , <u>plastic</u><br>(size) (material)                              |                                       |             |             |
| (6) pump <u>1/2</u> , <u>5</u><br>(HP) (yield gpm)                           |                                       |             |             |
| <u>electric</u><br>(type power)  |                                       |             |             |
| (7) electric log <u>no</u><br>(yes or no)                                    |                                       |             |             |
| (organization running log)   |                                       |             |             |
| (8) how well bottom plugged <u>plugged</u>                                   |                                       |             |             |
| DRILLERS REMARKS:  |                                       |             |             |

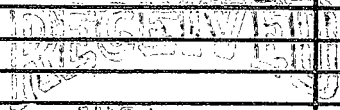

If well telescopes please sketch and show depths.

GROUND LEVEL

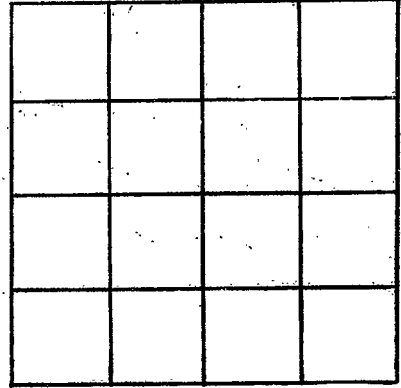

SECTION \_\_\_\_\_

Please indicate well location X.

ADDITIONAL INFORMATION

If more than one screen, show locations of each on sketch.