

Parola
Ø 33
10-21-74

MISSISSIPPI
 BOARD OF WATER COMMISSIONERS
 416 North State Street
 Jackson, Mississippi 39201

CODED

WATER WELL DRILLERS LOG

10-21 1974 Bob Smith Well Drilling Parola
 date well completed firm name county well located

LANDOWNER: Mac Charlton
Charlton's One Stop
Kateville, Miss.
Parola, Miss.
 (mailing address)


description of formations encountered	from	to
<u>Red clay</u>	<u>0'</u>	<u>5'</u>
<u>Red sand</u>	<u>5'</u>	<u>60'</u>
<u>Blue clay</u>	<u>60'</u>	<u>120'</u>
<u>White sand</u>	<u>120'</u>	<u>165'</u>

WELL LOCATION:
 sec. 30 T. 8 N. R. 5 E 15F
6 miles NE of Jardis
 (distance) (direction) (nearest town)
road behind dam

WELL PURPOSE: home
 (home, irrigation, municipal, industrial)

CODED


- WELL COMPLETION DATA:
- (1) diameter (inches) 4
 - (2) total depth (feet) 165'
 - (3) static water level (feet) 100 below above top of ground.
 - (4) casing plastic, 165'
 (material) (depth)
 (size) if telescope see back.
 - (5) screen 10', 155'
 (length) (depth to top)
4, plastic
 (size) (material)
 - (6) pump 1/2 10
 (HP) (yield gpm)
electric
 (type power)
 - (7) electric log no
 (yes or no)
 (organization running log)
 - (8) how well bottom plugged plugged

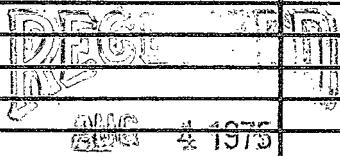

DRILLERS REMARKS:

If well telescopes please sketch and show depths.

GROUND LEVEL

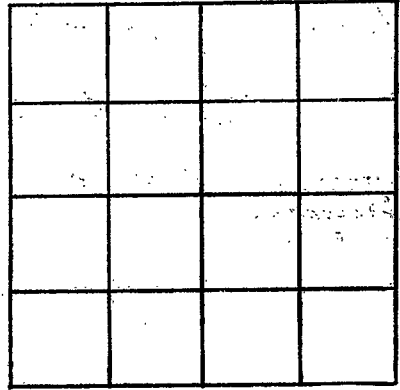

SECTION _____

Please indicate well location X.

ADDITIONAL INFORMATION

If more than one screen, show locations of each on sketch.