

PANOLA
 Φ35
 4/79
 El Log #61

MISSISSIPPI
 BOARD OF WATER COMMISSIONERS
 416 North State Street
 Jackson, Mississippi 39201

CODED

WATER WELL DRILLERS LOG

4-1979 Robert G. Ratteff Co. Inc. Panola
 date well completed firm name county well located

LANDOWNER: Gardin Lake
Community W. A.

description of formations encountered	from	to
---------------------------------------	------	----

(mailing address)

Clay & sand	0	21
sand & gravel	21	42
sand	42	63

WELL LOCATION:
 sec. 28 T 8 S R 5 E W
 14 miles east of Batesville
 (distance) (direction) (nearest town)

sand & clay	63	84
sandy clay	84	105
sandy clay	105	126
sandy clay	126	147
sandy clay	147	240

WELL PURPOSE:
 (home, irrigation, municipal, industrial)

sand	240	300
Clay	300	340
Clay & rocks	340	380

WELL COMPLETION DATA:

- (1) diameter (inches) 10 x 6
- (2) total depth (feet) 663
- (3) static water level (feet) 126 below top of ground.
- (4) casing Steel (material), 606 (depth)
- 10 (size) if telescope see back.
- (5) screen 40' (length), 553 (depth to top)
- 6" (size), 55 Screens (material)
- (6) pump 60 (HP), 300 (yield gpm)
- electric (type power)
- (7) electric log yes (yes or no)
- State (organization running log)
- (8) how well bottom plugged BPT

Clay	380	460
Clay & rocks	460	493
sand	493	513
sandy clay	513	533
sandy shale	533	593
sand	593	653
sand & clay	653	673
Clay	673	713
Sand & clay	713	793
sand	793	833
Clay	833	853
Clay	853	873

DEPT. OF NATURAL RESOURCES
 BUREAU OF LAND & WATER RESOURCES

MAR 24 1980


DRILLERS REMARKS:

RECEIVED

0

If well telescopes please sketch and show depths.

GROUND LEVEL

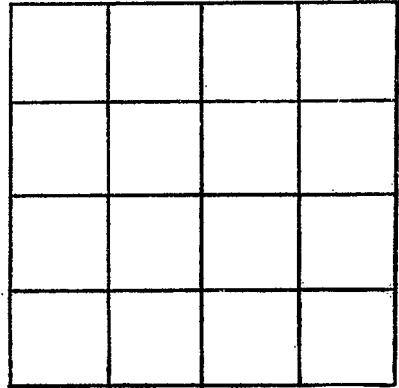

SECTION _____

Please indicate well location X.

ADDITIONAL INFORMATION

If more than one screen, show locations of each on sketch.