




If well telescopes please sketch and show depths.

GROUND LEVEL

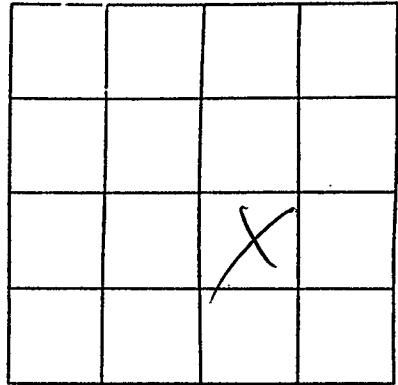

SECTION 0-29

Please indicate well location X.

Pump Capacity (GPM)	No. of Stages	Setting Depth	FT.
<u>12</u>	<u>10</u>	<u>100</u>	

PUMP TEST

Well yielded 16 GPM with  
 a drawdown of 3 ft.  
 after 1 hours of pumping

LOG DATA

TYPE OF LOG RUN (Circle One): No Log Run, Electric, Gamma Ray, Density, Sonic, Neutron, Other (Describe) \_\_\_\_\_

Name of Organization Running Log \_\_\_\_\_

GEOLOGIC DATA (Office Use Only)

Surface Elev.	Geologic Unit	Unit Thickness	Depth to Top
Subs. SWL	Date	Analysis	Aquifer Test

Driller's Remarks

---



---



If more than one screen, show location of each on sketch.