

PANOLA
 2001
 7-27-77

MISSISSIPPI
 BOARD OF WATER COMMISSIONERS
 416 North State Street
 Jackson, Mississippi 39201

WATER WELL DRILLERS LOG

July 27 1977 Lipe Well Co. Panola
 date well completed firm name county well located

LANDOWNER:
 M. L. Lewis
 Batesville Ms.
 (mailing address)

WELL LOCATION:
 sec 21 T 8 N R 5 E
 10 miles east of Batesville
 (distance) (direction) (nearest town)

WELL PURPOSE:
 (home, irrigation, municipal, industrial)

- WELL COMPLETION DATA:
- (1) diameter (inches) 4
 - (2) total depth (feet) 195
 - (3) static water level (feet) 140 below top of ground
 - (4) casing PVC 185 (material) (depth)
 4 (size) if telescope see back.
 - (5) screen 10 185 (length) (depth to top)
 4 PVC (size) (material)
 - (6) pump 3/4 10 (HP) (yield gpm)
 elec. (type power)
 - (7) electric log NO (yes or no)
 NO (organization running log)
 - (8) how well bottom plugged PVC CAP

description of formations encountered	from	to
Top Soil	0	20
sand	20	40
"	40	60
"	60	80
Clay	80	100
"	100	120
"	120	140
sand and clay	140	160
good sand	160	195


RECEIVED
 AUG - 1 1977

MISS. BD. OF WATER COMMISSIONERS

DRILLERS REMARKS:

If well telescopes please sketch and show depths.

GROUND LEVEL

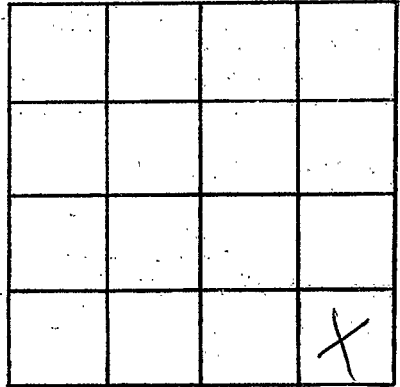

SECTION 2/

Please indicate well location X.

ADDITIONAL INFORMATION

If more than one screen, show locations of each on sketch.