

7-8-80

2004
7-8-80

MISSISSIPPI
BOARD OF WATER COMMISSIONERS
416 North State Street
Jackson, Mississippi 39201

WATER WELL DRILLERS LOG

7-8-80 date well completed
1980 Life Well Co. firm name
Panola county well located

LANDOWNER:
Tommy Cranford
Batesville Ms.
(mailing address)

description of formations encountered	from	to
	TOP soil	0
red sand	20	60
clay and sand	60	80
sand	80	110
blue clay	110	140
good sand	140	188

WELL LOCATION:
sec 9 T 8 N R 5 E
10 miles east of Batesville
(distance) (direction) (nearest town)

WELL PURPOSE:
(home, irrigation, municipal, industrial)

- WELL COMPLETION DATA:
- (1) diameter (inches) 4
 - (2) total depth (feet) 188
 - (3) static water level (feet) 80 below top of ground.
 - (4) casing PVC, 178
(material) (depth)
4 if telescope see back.
(size)
 - (5) screen 10, 178
(length) (depth to top)
4, PVC
(size) (material)
 - (6) pump 3/4, 10
(HP) (yield gpm)
elec.
(type power)
 - (7) electric log No
(yes or no)
NON
(organization running log)
 - (8) how well bottom plugged PVC
CAP

DRILLERS REMARKS:


DEPT. OF NATURAL RESOURCES
BUREAU OF LAND & WATER RESOURCES

JUL 17 1980

RECEIVED

If well telescopes please sketch and show depths.

GROUND LEVEL

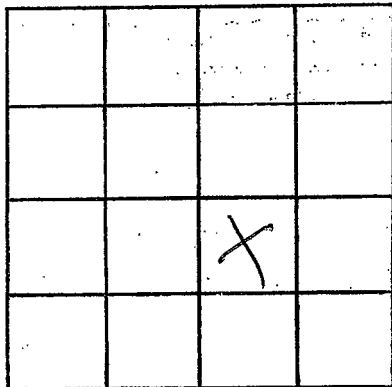

SECTION 9

Please indicate well location X.

ADDITIONAL INFORMATION

If more than one screen,
show locations of each on sketch.