

NO LA
2006

MISSISSIPPI
 BOARD OF WATER COMMISSIONERS
 416 North State Street
 Jackson, Mississippi 39201

WATER WELL DRILLERS LOG

July 2 1984 Lipid Well Supply Pearlola
 date well completed firm name county well located

LANDOWNER: Bob Church
Boonville MS

description of formations encountered	from	to
<u>Clay & sand</u>	<u>0</u>	<u>20</u>
<u>clay streaked sand</u>	<u>20</u>	<u>100</u>
<u>med edge sand</u>	<u>100</u>	<u>120</u>
<u>sand streaked clay</u>	<u>120</u>	<u>150</u>
<u>Dead</u>	<u>150</u>	<u>160</u>

(mailing address)

WELL LOCATION:

sec. 14 T. 8 N R. 5 E
8 miles S + E of Boonville
 (distance) (direction) (nearest town)

WELL PURPOSE: home
 (home, irrigation, municipal, industrial)

WELL COMPLETION DATA:

- (1) diameter (inches) 4
- (2) total depth (feet) 160
- (3) static water level (feet) 90 below top of ground. above
- (4) casing PVC, 152
 (material) (depth)
4 if telescope see back.
 (size)
- (5) screen 8, 152
 (length) (depth to top)
4, PVC
 (size) (material)
- (6) pump 3/4, 10
 (HP) (yield gpm)
elec
 (type power)
- (7) electric log No
 (yes or no)

(organization running log)

(8) how well bottom plugged PVC
cap

DRILLERS REMARKS:


DEPT. OF NATURAL RESOURCES
 BUREAU OF LAND & WATER RESOURCES

JUL 10 1984

RECEIVED

If well telescopes please sketch and show depths.

GROUND LEVEL

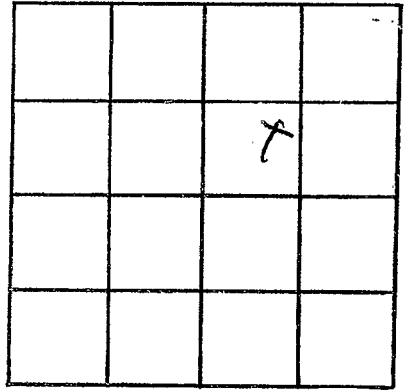

SECTION _____

Please indicate well location X.

ADDITIONAL INFORMATION

If more than one screen,
show locations of each on sketch.