

MISSISSIPPI DEPARTMENT OF NATURAL RESOURCES

Bureau of Land and Water Resources

COUNTY WELL LOCATED P2N012	
WELL NUMBER 0208	CODED
DATE WELL COMPLETED 5-13-90	

PERMIT NUMBER	NAME OF DRILLING PARTY HICKS WELL CO.
RT. 1 BOX 157	
SENATOBIA, MS 38668	

P.O. Box 10631
Jackson, Mississippi 39209
WATER-WELL DRILLERS LOG

NAME & MAILING ADDRESS OF LANDOWNER Joe CATSIEMAN		
SARDI'S		
MS		
WELL LOCATION:	SEC	TOWNSHIP RANGE
	19	8 ^N _S ^W _E
DISTANCE	DIRECTION	NEAREST TOWN
10 Miles	NE	BATSVIL
OTHER LANDMARK BLACK JACK ACRD		
WELL PURPOSE (Home Irrigation, Municipal, Industrial, Fish Pond, etc.)		

PUMP DATA		
PUMP TYPE (Circle One): <input checked="" type="radio"/> Submersible Turbine, Jet Flowing Well, Other (Describe) _____		
POWER TYPE (Circle One): <input checked="" type="radio"/> Electric, Tractor, Diesel, Gasoline, Butane, Other (Describe) _____ H/P 1		
Pump Capacity (GPM) 18	No. of Stages 18	Setting Depth 130 FT.
PUMP TEST		
Well yielded 18 GPM with a drawdown of _____ ft. after _____ hours of pumping		

WELL DATA		
Well Depth 163	Casing Diameter (In.) 4"	Casing Length (Ft.) 143
Type of Casing PVC	Hole Depth 163	Depth to Static Water Level 120
TYPE OF COMPLETION: (Circle One or More): Gravel Packed, Underreamed, Telescoped, Natural Development, Open Hole, Other (Describe) _____		
Top of Lap Pipe or Reduction in Casing FEET IF TELESCOPED OR MORE THAN ONE SCREEN; USE BACK PAGE		

LOG DATA	
TYPE OF LOG RUN (Circle One): Electric, Gamma Ray, Density, Sonic, Neutron, Other (Describe) _____	
Name of Organization Running Log	


SCREEN DATA		
Diameter - Inches 4"	Length - Feet 20	Slot Size - Inches 013
Screen Type PVC	Depth to Bottom - Feet 163	

GEOLOGIC DATA (Office Use Only)			
Surface Elev.	Geologic Unit	Unit Thickness	Depth to Top
Subs. SWL	Date	Analysis	Aquifer Test
Driller's Remarks			

DESCRIPTION OF FORMATIONS ENCOUNTERED	FROM	TO	FORMATIONS (Continued)	FROM	TO
RS & C	0	20	RECEIVED		
CLAY W.S.	20	90			
W. S & C	90	130			
W S.	130	163			
			JUN 07 1990		
			Department of Natural Resources Bureau of Land & Water Resources		
IF MORE SPACE IS NEEDED, USE BACK					

If well telescopes please sketch and show depths.

GROUND LEVEL

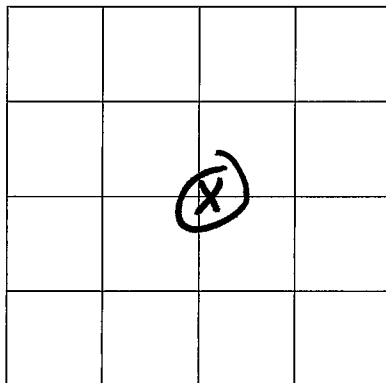

SECTION _____

Please indicate well location X.

ADDITIONAL INFORMATION

If more than one screen,
show location of each on sketch.