

**MISSISSIPPI DEPARTMENT OF ENVIRONMENTAL QUALITY**

Office of Land and Water Resources

COUNTY WELL LOCATED <u>Parola</u>	
WELL NUMBER <u>CP 2012</u>	CODED
DATE WELL COMPLETED <u>8-1-94</u>	

PERMIT NUMBER <b>HICKS WELL CO.</b>
NAME OF DRILLING FIRM <b>RTM 1 BOX 157 SENATOBIA, MS 38668</b>

P. O. Box 10631  
Jackson, MS 39289-0631  
**WATER WELL DRILLERS LOG**

NAME & MAILING ADDRESS OF LANDOWNER <u>Raymond D Sutton</u>		
<u>2961 Kingston Rd</u>		
<u>Memphis Tenn</u>		
WELL LOCATION:	SEC	TOWNSHIP RANGE
	<u>33</u>	<u>8 N 5 E</u>
DISTANCE	DIRECTION	NEAREST TOWN
<u>5</u> Miles	<u>west</u> of	<u>Oxford</u>
OTHER LANDMARK		
WELL PURPOSE <input checked="" type="checkbox"/> Home Irrigation, Municipal, Industrial, Fish Pond, etc.		

<b>PUMP DATA</b>		
PUMP TYPE (Circle One): <input checked="" type="checkbox"/> Submersible, Turbine, Jet, Flowing Well, Other (Describe) _____		
POWER TYPE (Circle One): <input checked="" type="checkbox"/> Electric, Tractor, Diesel, Gasoline, Butane, Other (Describe) _____ H/P <u>3/4</u>		
Pump Capacity (GPM) <u>10</u>	No. of Stages	Setting Depth <u>160</u> FT.
PUMP TEST		
Well yielded _____ GPM with a drawdown of _____ ft. after _____ hours of pumping		

<b>WELL DATA</b>		
Well Depth <u>220</u>	Casing Diameter (In.) <u>4"</u>	Casing Length (Ft.) <u>210</u>
Type of Casing <u>Pvc</u>	Hole Depth <u>220</u>	Depth to Static Water Level <u>130</u>
TYPE OF COMPLETION: (Circle One or More): <input checked="" type="checkbox"/> Gravel Packed, Underreamed, Telescoped, <input type="checkbox"/> Natural Development, <input type="checkbox"/> Open Hole, <input type="checkbox"/> Other (Describe) _____		
WELL GROUTED TO A DEPTH OF <u>4</u> FEET Type Grout (circle one): <input checked="" type="checkbox"/> Cement, Bentonite, or Mix		

<b>LOG DATA</b>	
TYPE OF LOG RUN (Circle One): <input type="checkbox"/> No Log Run, Electric, Gamma Ray, Density, Sonic, Neutron, Other (Describe) _____	
Name of Organization Running Log	

<b>SCREEN DATA</b>		
Diameter - Inches <u>4"</u>	Length - Feet <u>10'</u>	Slot Size - Inches <u>.013</u>
Screen Type <u>Pvc</u>	Depth to Bottom - Feet <u>220</u>	

<b>GEOLOGIC DATA (Office Use Only)</b>			
Surface Elev.	Geologic Unit	Unit Thickness	Depth to Top
Subs. SWL	Date	Analysis	Aquifer Test
Driller's Remarks			
Top of Lap Pipe or Reduction in Casing			
FEET		IF TELESCOPED OR MORE THAN ONE SCREEN: USE BACK PAGE	

DESCRIPTION OF FORMATIONS ENCOUNTERED	FROM	TO	FORMATIONS (Continued)	FROM	TO
<u>Red Sand</u>	<u>0</u>	<u>40</u>			
<u>SAND &amp; CLAY</u>	<u>40</u>	<u>140</u>			
<u>CLAY</u>	<u>140</u>	<u>180</u>			
<u>White Sand</u>	<u>180</u>	<u>220</u>			

**RECEIVED**


**SEP 08 1994**

Dept. of Environmental Quality  
Office of Land & Water Resources

IF MORE SPACE IS NEEDED, USE BACK

If well telescopes please  
sketch and show depths.

GROUND LEVEL

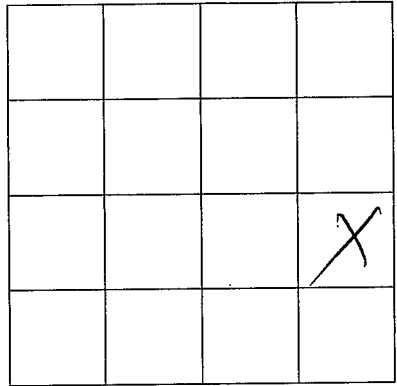

SECTION 33

Please indicate well location X.

ADDITIONAL INFORMATION

Multiple horizontal lines for writing additional information.

If more than one screen,  
show location of each on sketch.