

PANOLA
P 1
2-24-71

MISSISSIPPI
BOARD OF WATER COMMISSIONERS
416 North State Street
Jackson, Mississippi 39201

CODED

WATER WELL DRILLERS LOG

Feb 24 1971 J. B. Cain PANOLA
date well completed firm name county well located

LANDOWNER: Jarrell Paulk

description of formations encountered

from

to

Buckshot clay
WATER SAND

0 30
30 70

(mailing address)

WELL LOCATION:

sec 21 T N R 90 E
90 S
miles (distance) of (direction) (nearest town)

WELL PURPOSE: HOME
(home, irrigation, municipal, industrial)

WELL COMPLETION DATA:

- (1) diameter (inches) 4"
- (2) total depth (feet) 70
- (3) static water level (feet) 30' below above top of ground.
- (4) casing Plastic, 65',
(material) (depth)
4
(size) if telescope see back.
- (5) screen 5', 70'
(length) (depth to top)
4, GRAVEL PACK
(size) (material)
- (6) pump 1/2 (HP) (yield gpm)
320
(type power)

(7) electric log _____
(yes or no)

(organization running log)

(8) how well bottom plugged Washed Bottom

DRILLERS REMARKS:


CODED

APR - 6 1971

MISS. RD. OR
WATER COM.

If well telescopes please sketch and show depths.

GROUND LEVEL

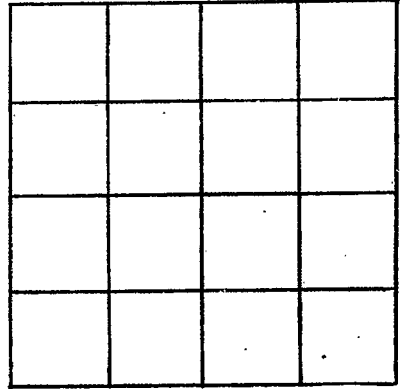

SECTION _____

Please indicate well location X.

ADDITIONAL INFORMATION

If more than one screen,
show locations of each on sketch.