

PANOLA

MISSISSIPPI BOARD OF WATER COMMISSIONERS

PANOLA

P2
10-3-63

WATER WELL DRILLERS LOG

Date: 1/9/63, 1963, Driller:

ELLIOTT HARDV...
OXFORD, MISSISSIPPI County
(Name)

CODED

Loggett

- (1) Owner of Land: *Wade Cole*
Batesville, Miss
(Name) (Address)
- (2) Location: $\frac{1}{4}$, $\frac{1}{4}$, Sec *38* T *6* R *5*
15 miles *West*, of *Batesville*
(distance) (direction) (Nearest Town)
- (3) Topography: *Hilly*
(Hilly) (Flat) (Level)
- (4) Purpose of Well: *Domestic*
(Domestic Irrigation
Municipal, Industrial, Other)

Description & Color of Materials Sand, Clay, Red Clay, Shell, etc.	Thick- ness Feet	Depth Feet
<i>Clay</i>	<i>110</i>	<i>110</i>
<i>sand</i>	<i>125</i>	<i>235</i>


Information upon completion of well:

- (1) Diameter *4* inches.
- (2) Total Depth *235* feet.
- (3) Water Level *105* feet below top of ground.
- (4) Cased to *No*, Size
- (5) Screen: Size *2 1/2*, Length *20*.
- (6) Were any formations sealed against pollution?
 yes, no.

CODED

If YES depth of formation _____
Why _____

Drillers Remarks: _____

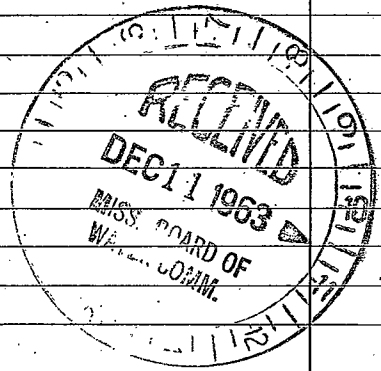

(Use Back Side)

Well No.

