

MISSISSIPPI DEPARTMENT OF NATURAL RESOURCES
 Bureau of Land and Water Resources
 Southport Mall
 P.O. Box 10631
 Jackson, Mississippi 39209
WATER WELL DRILLERS LOG

LOGGED

PANOLA
P3
8-12-80

Aug 12 1980 Larry's Well & Pump Panola
 date well completed firm name county well located

LANDOWNER: Con Agra
Isola, MS
 (mailing address)
 WELL LOCATION:
 sec. 15 T 9 N R 9 E
10 miles E of Patessville
 (distance) (direction) (nearest town)

description of formations encountered	from	to
<u>clay</u>	<u>0</u>	<u>22</u>
<u>med sand</u>	<u>22</u>	<u>40</u>
<u>coarse sand</u>	<u>40</u>	<u>60</u>
<u>coarse sand & gr</u>	<u>60</u>	<u>105</u>

WELL PURPOSE: fresh pond
 (home, irrigation, municipal, industrial)

WELL COMPLETION DATA:
 (1) diameter (inches) 12"
 (2) total depth (feet) 105'
 (3) static water level (feet) 20 below above top of ground.
 (4) casing steel, 65'
 (material) (depth)
 (size) if telescope see back.
 (5) screen 40', 65'
 (length) (depth to top)
12", steel
 (size) (material)
 (6) pump 60, 2500
 (HP) (yield gpm)
E lattice
 (type power)
 (7) electric log NO
 (yes or no)
 (organization running log)
 (8) how well bottom plugged Steel Plate

DRILLERS REMARKS:

DEPT. OF NATURAL RESOURCES
 BUREAU OF LAND & WATER RESOURCES


MAY 18 1991

RECEIVED

0

If well telescopes please sketch and show depths.

GROUND LEVEL

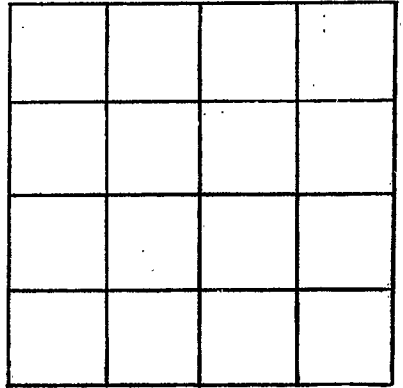

SECTION 15

Please indicate well location X.

ADDITIONAL INFORMATION

If more than one screen, show locations of each on sketch.