

~~72~~
Test Hole #2

Panola
P24
1-10-69
M.G.S.
1-10-1969

MISSISSIPPI
BOARD OF WATER COMMISSIONERS
416 North State Street
Jackson, Mississippi 39201

CODED
CODED

WATER WELL DRILLERS LOG

1969 JAMES R LIRE PANOLA
date well completed firm name county well located

LANDOWNER: F.L.C. WATER

description of formations encountered from to

ASSOC.
BATESVILLE MISS
(mailing address)

CLAY	0	40
SAND	40	110
CLAY	110	240
SAND	240	300
CLAY	300	320
SAND	320	360
CLAY	360	400
SAND+CLAY	400	420
SAND	420	460
CLAY	460	510
SAND	510	540
CLAY	540	562
SAND	562	620
CLAY HARD	620	1016
SAND	1016	1040
CLAYS AND	1040	1124
SAND-FINE	1124	1164

WELL LOCATION:
24 sec 28 T 28 N R 2 E

10 miles W of BATESVILLE
(distance) (direction) (nearest town)

WELL PURPOSE: COMMUNITY
(home, irrigation, municipal, industrial)

WELL COMPLETION DATA:

(1) diameter (inches) 8

(2) total depth (feet) 1164

(3) static water level (feet) 10' below top of ground.

(4) casing STEEL 115' (material) (depth)

6 (size) If telescope see back.

(5) screen 40' 1124' (length) (depth to top)

6" 55 (size) (material)

(6) pump 20 250 (HP) (yield gpm)

ELEC. (type power)

(7) electric log Yes (yes or no)

MISS. G.S. (organization running log)

(8) how well bottom plugged PLUG STEEL

FEB - 5 1969

CODED


MISS. BD. OF
WATER COMMISSIONERS

DRILLERS REMARKS:

None

If well telescopes please sketch and show depths.

GROUND LEVEL →

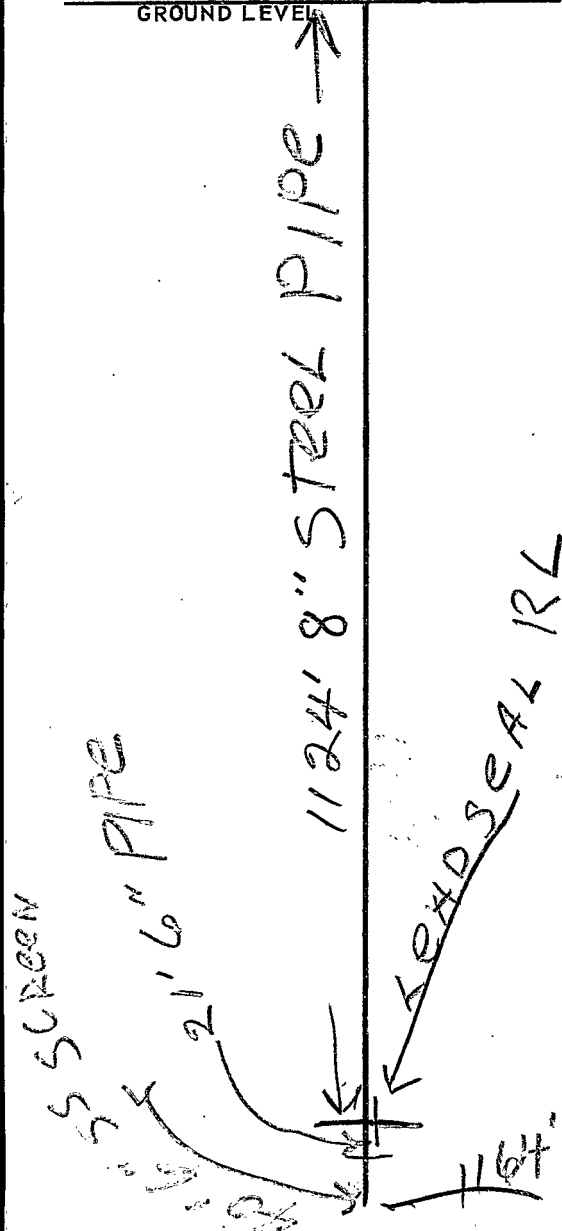

		X	
	X g.w.p.		

SECTION 24
2

Please indicate well location X.

ADDITIONAL INFORMATION

Blank lined area for additional information.

If more than one screen, show locations of each on sketch.