

E LOG # 39

PANOLA
P 25
8-13-69
USGS

MISSISSIPPI
BOARD OF WATER COMMISSIONERS
416 North State Street
Jackson, Mississippi 39201

WATER WELL DRILLERS LOG

CODED

August 13 19 69 Layne-Central Company Panola
date well completed firm name county well located

LANDOWNER: Enon-Locke Station
& Curtiss Water Association

description of formations encountered from to

Batesville, Mississippi
(mailing address)

Clay	15	15
Sand	130	115
Sand & small gravel	140	10
Sandy clay	226	86
Sand	300	74
Sand & shale sts.	356	56
Shale & sand sts.	400	44
Sand & shale	450	50
Sandy shale	575	125
Sand & shale sts.	625	50
Clay	696	71
Rocks & clay	730	34
Tough clay	830	100
Clay	873	43
Rock	875	2
Clay	980	105
Sandy clay	1081	101
Sand & clay	1131	50
Sand	1165	34
Shale	1168	3
Sand	1178	10

WELL LOCATION:
sec. 24 9S T ~~XX~~ S R 9 ~~XX~~ W
1 miles West of Tenn. Gas
(distance) (direction) (nearest town)

WELL PURPOSE: Municipal
(home, irrigation, municipal, industrial)

WELL COMPLETION DATA:

- (1) diameter (inches) 8"
- (2) total depth (feet) 1168'
- (3) static water level (feet) 8' ~~xxxx~~ above top of ground.
- (4) casing Steel, 1132', (material) (depth)
8" (size) If telescope see back.
- (5) screen 30', 1134' (length) (depth to top)
6" stainless steel (size) (material)
15 175 (HP) (yield gpm)
- Electric (type power)
- (7) electric log U.S.G.S. (yes or no) Jackson, Miss.
(organization running log)
- (8) how well bottom plugged


DRILLERS REMARKS:

CODED

MISSISSIPPI
BOARD OF WATER COMMISSIONERS
JACKSON, MISSISSIPPI

If well telescopes please sketch and show depths.

GROUND LEVEL

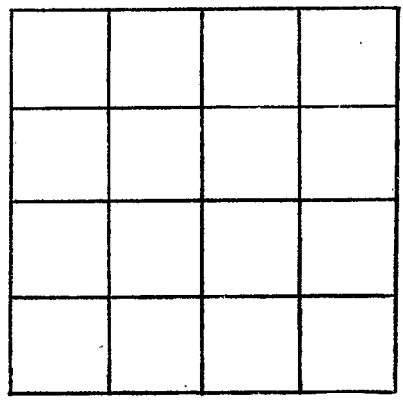

SECTION _____

Please indicate well location X.

ADDITIONAL INFORMATION

Lined area for providing additional information, consisting of approximately 20 horizontal lines.

If more than one screen, show locations of each on sketch.