

GW 10637

CODED

PANOLA
P 26
8-29-69

MISSISSIPPI
BOARD OF WATER COMMISSIONERS
416 North State Street
Jackson, Mississippi 39201

CODED

WATER WELL DRILLERS LOG

8-29-69
date well completed

19 *DeWitt County*
firm name

Panola
county well located

LANDOWNER: *Mt M DeWitt*
Batesville, Miss.

description of formations encountered	from to	
<i>Clay</i>		<i>20</i>
<i>Sand</i>	<i>20</i>	<i>29</i>
<i>Sand gravel</i>	<i>40</i>	<i>46</i>
<i>Sand</i>	<i>46</i>	<i>53</i>
<i>Sand gravel</i>	<i>53</i>	<i>105</i>

(mailing address)

WELL LOCATION:

sec. *15* T *9* N R. *2 E* *9 W*

3 1/2 miles *South* of *DeWitt*
(distance) (direction) (nearest town)

WELL PURPOSE: *Just Pond*
(home, irrigation, municipal, industrial)

WELL COMPLETION DATA:

- (1) diameter (inches) 16"
- (2) total depth (feet) 105'
- (3) static water level (feet) 10' below above top of ground.
- (4) casing Steel Pipe 57' (material) (depth)
16" if telescope see back. (size)
- (5) screen 48' 57' (length) (depth to top)
16" Draw Screen (size) (material)
- (6) pump _____ (HP) _____ (yield gpm)

(type power)
- (7) electric log _____ (yes or no)

(organization running log)
- (8) how well bottom plugged Washed

CODED


DRILLERS REMARKS:

SEP 2 1969
MISSISSIPPI
STATE BOARD OF WATER COMMISSIONERS

0

If well telescopes please
sketch and show depths.

GROUND LEVEL

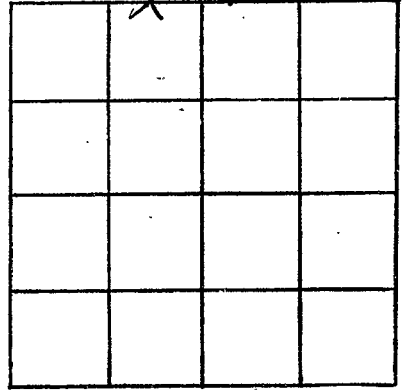

SECTION 15

Please indicate well location X.

ADDITIONAL INFORMATION

If more than one screen,
show locations of each on sketch.